




TOWN OF LEXINGTON — BOARD OF PUBLIC WORKS

SEWER DIVISION

Sketch of Service Here

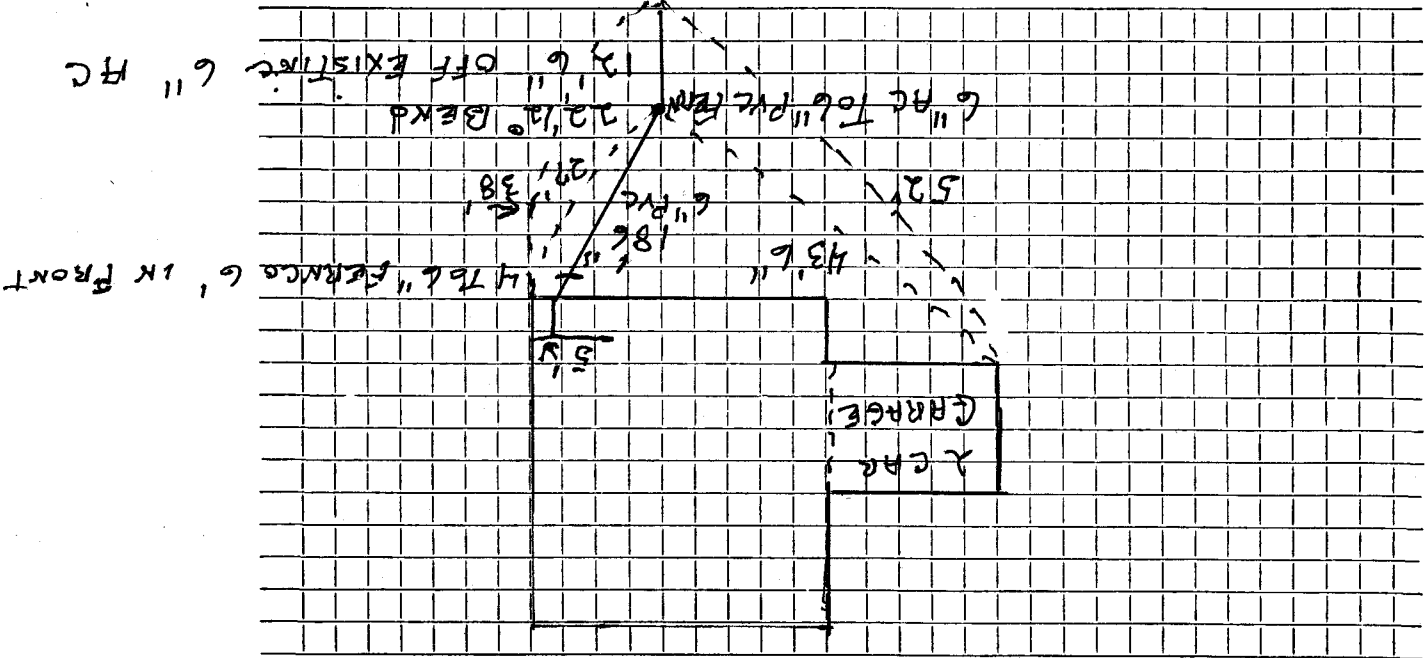

Work completed

Street

ST. HASSELL

Connection made in

Remarks: Installed by J. McLaughlin