

Name

Arthur Marson

Service No. 138

Address

33 Haskell Street, Lexington, Mass.

Location

Com. 12-2-57

Kind of Pipe

Size

Size of Main

Replacements - New Service

Location

Date	Material	Amount	Total	Date	Amount
10-16-57	Labor	60 42		8-22-57	200 00
	10% overhead	6 04	66 46	12-2-57	90 91
	30'-6" Transite Pipe @.70		21 00		7109 09
	1-6" Clay Elbow		1 88		
	2 hrs. Town Shovel @ 6.50		13 00		
	1 hr. Trucking @.75		75		
	1 hr. Rodgers Trailer @ 3.00		3 00		
	1 hr. Trucking @ 3.00		3 00		
			109 09		
	Labor			9-14-58	
				9-21-58	
				10-27-00	

Deposit
 Refund

No Problem
 Block Serv.
 Roots in manhole
 Roots at MH Respond

TOWN OF LEXINGTON—DEPT. OF PUBLIC WORKS

SEWER DIVISION


DATE..... NO.....

The undersigned applies for the construction of a particular sewer connecting No.....
Street and hereby agrees to comply with the Rules and Regulations governing the construction and use of Particular
Sewers, as now or at any future time established by the Board of Selectmen.

Am't of estimate \$.....
Am't Paid \$.....

Owner.....

Sketch of Service Here

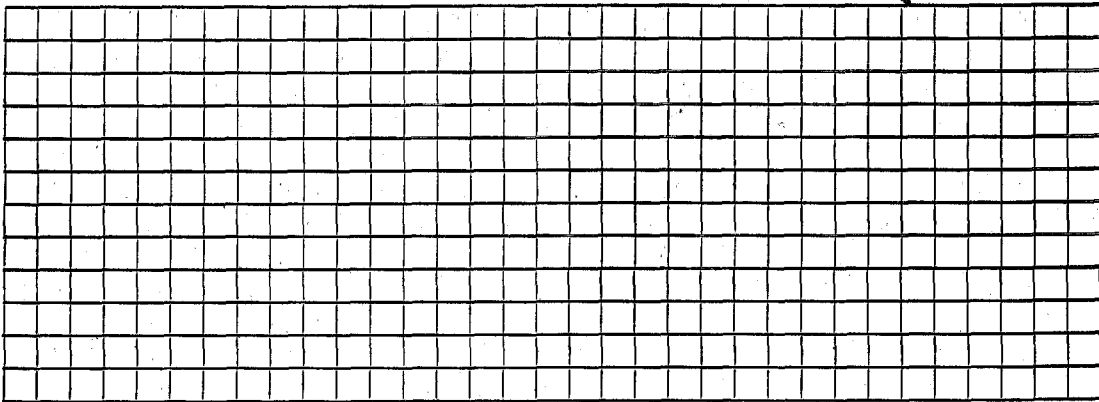

Connection made in..... SERVICE..... COMES..... Street.....
Remarks:.....
Work completed..... 19.....

INTO
M/H