

Name

Service No.

Address 7 HASKELL ST

Location

Kind of Pipe

Size

Repair—Renewal—New Service

Location

MCLAUGHLIN


Date	Material	Amount	Total	Date	Amount
5/28/99	38' 6" PVC				
1	6" Ferroc				
1	4x6 Ferroc				
1	45°				
1	CLEANOUT				
6'	4" PVC				

TOWN OF LEXINGTON — BOARD OF PUBLIC WORKS

SEWER DIVISION

DATE _____

Sketch of Service Here

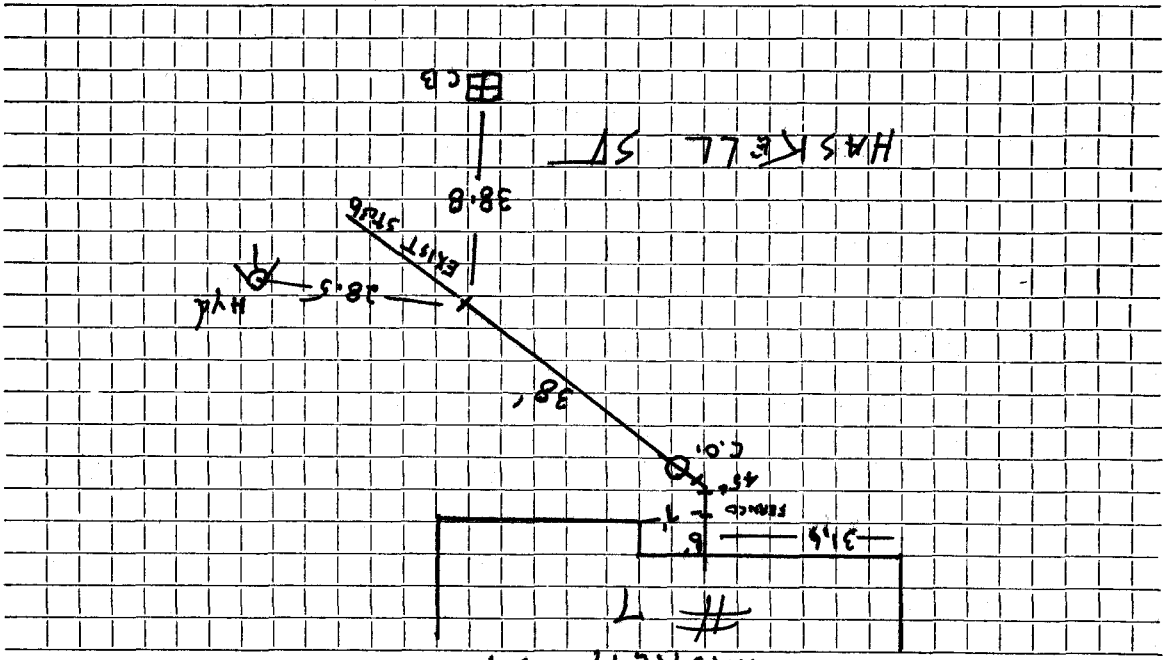

Connection made in _____ Street. Work completed _____

Remarks: _____