

Name **Dr. Howard Asarkof**

Service No. //

Address **21 Hastings Road**

Location

Kind of Pipe

Size

Size of Main

~~REPAIR-REMOVAL~~—New Service **W. O. #6161** Cont. David Eagle

#1312

Location **MAY 27 1969**


Date	Material	Amount	Total	Date	Amount
4/22/69	Labor	51 72		4-17-69	240 00
5/2/69	"	13 64	78 00	5-27-69	85 49
	10% O.H.		7 80	4-22-69	144 53
	22' 6" Transite .88		19 36	22'	6" Transite
	1/2 Bag cement, 1.55		78		
	1 Dozen brick @ 0.43		4 38		
	1/2 Ton cold patch 5.50		2 75		
	1 " hot top		5 80		
	2 1/2 Hrs. trucking 3.00		7 50		
	2 " " 1.50		3 00		
	2 " Shovel 6.50		13 00		
	1/2 " Compressor 5.00		2 50		
	1/2 " Roller 3.00		1 50		
	Trailer		2 00		
			144 53		
4-24-69	110' 6" Transite pipe				
22	4" Cast Iron pipe				

TOWN OF LEXINGTON — BOARD OF PUBLIC WORKS

SEWER DIVISION

DATE _____

Sketch of Service Here
21
 Lot 21 & Pt 22

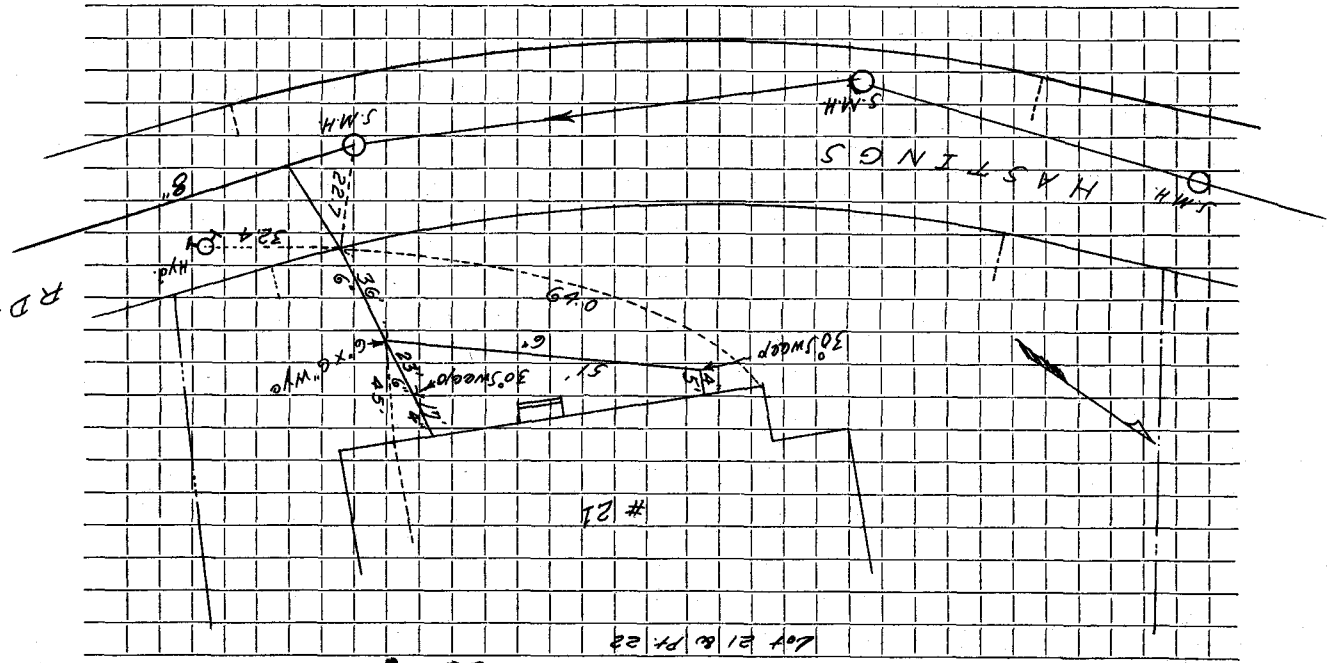

Connection made in _____ Street. Work completed _____

Remarks: _____