

Name Louis Tropeano

Service No. 90

Address 22 Hastings Road

Location *Command. 11-19-56*

Kind of Pipe _____ Size _____ Size of Main _____ Location _____

Repairs/Recovery—New Service

Date	Material	Amount	Total	Date	Amount
7/31/56	Labor	8 67		7-12-56	<i>Deposit</i>
8/13/56	"	9 00		11-19-56	<i>Refund</i>
8/14/56	"	58 50			
	10% overhead	76.17			
	10% overhead	7 62	83 79		
	90' - 6" Sewer pipe @ \$.455		40 95		
	Joint compound		5 40		
	1 - 6" Bend		1 88		
	1 2/3 hrs. Littlefield Shovel @ \$.50-14		16 16		
	3 hrs. trucking @ .75		2 25		
			148 43		
	Labor				<i>\$30.60 applied to w.N.C.#207</i>

\$250 00
101 57
148 43

TOWN OF LEXINGTON—DEPT. OF PUBLIC WORKS

SEWER DIVISION


DATE.....
NO.....

The undersigned applies for the construction of a particular sewer connecting No.
Street and hereby agrees to comply with the Rules and Regulations governing the construction and use of Particular
Sewers, as now or at any future time established by the Board of Selectmen.

Am't of estimate \$.....
Am't Paid \$.....

Owner.....

Sketch of Service Here

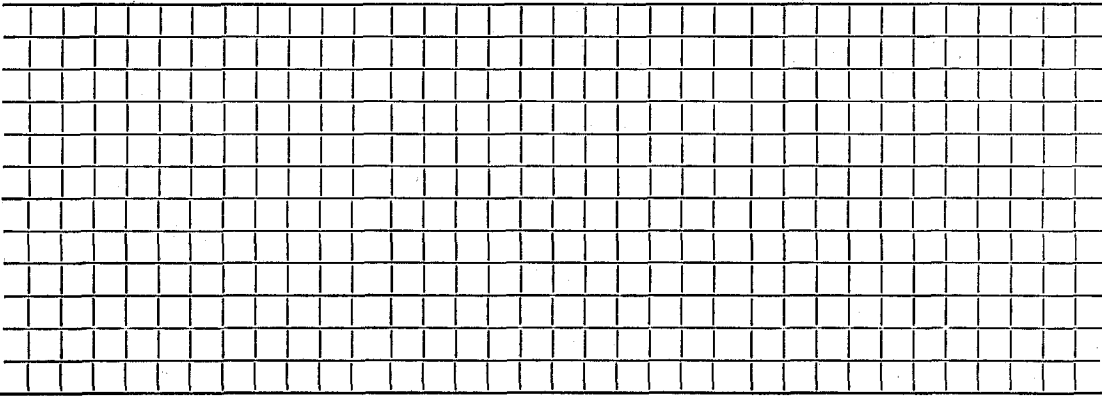

Connection made in Street.
Work completed 19..

Remarks: