

Name Harvey W. Newgent  
 Address 15 Hastings Road

Service No. 25

**Location**

Kind of Pipe \_\_\_\_\_ Size \_\_\_\_\_ Size of Main \_\_\_\_\_  
~~REPAIR-REMOVAL~~—New Service Comm 9-24-56 Location \_\_\_\_\_

Date	Material	Amount	Total	Date	Amount
4/13/56	Labor	33 50		4-9-56	Deposit
	10% overhead	3 35	36 85	4-24-56	Refund
88' 6"	Sewer Pipe @.3645		32.08		
	Joint compound		5 28		
6 hrs.	Littlefield @ 8.50		51.00		
2 hrs	trucking @ .75		1 50	* \$15.00 applied to W.N.C # 68	
			126.71		

TOWN OF LEXINGTON—DEPT. OF PUBLIC WORKS

SEWER DIVISION

DATE ..... NO. ....


The undersigned applies for the construction of a particular sewer connecting No. ....  
Street and hereby agrees to comply with the Rules and Regulations governing the construction and use of Particular  
Sewers, as now or at any future time established by the Board of Selectmen.

Am't of estimate \$.....

Am't Paid \$.....

Owner .....

Sketch of Service Here

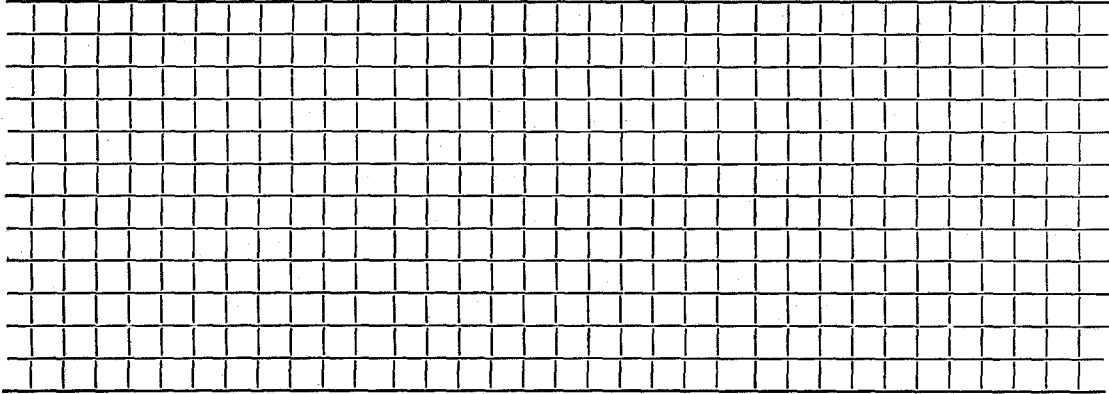

Connection made in ..... Street. Work completed ..... 19..

Remarks: