

Name Mrs. Blanche E. Rudd

Service No. 15 362

Address 5 Hastings Road

Location 5 Hastings Road

Kind of Pipe

Size

Size of Main

Repair—Renewal—New Service

Location

Date	Material	Amount	Total	Date	Amount
Aug. 4, '44	Labor	8 40			110 00
	"	3 00		May 25 '45	18 43
5, '44	"	14 00			128 43
7, '44	"	37 40			
8, '44	"	24 40	87 20		
	10% Overhead		8 72		
	42'-6" Sewer Pipe @.22		9 24		
	10'-4" Soil Pipe @.50		5 00		
	Joint Comp.		2 52		
	1 hr. Comp. @ 1.75		1 75		
	1 hr. Trucking @ .75		75		
	Labor 3 hrs. Hoist @ 1.75		5 25		
	Patching		8 00		
			128 43		

TOWN OF LEXINGTON—DEPT. OF PUBLIC WORKS

SEWER DIVISION

DATE


The undersigned applies for the construction of a particular sewer connecting No.

Street and hereby agrees to comply with the Rules and Regulations governing the construction and use of Particular Sewers, as now or at any future time established by the Board of Selectmen.

Am't of estimate \$

Am't Paid \$

Owner

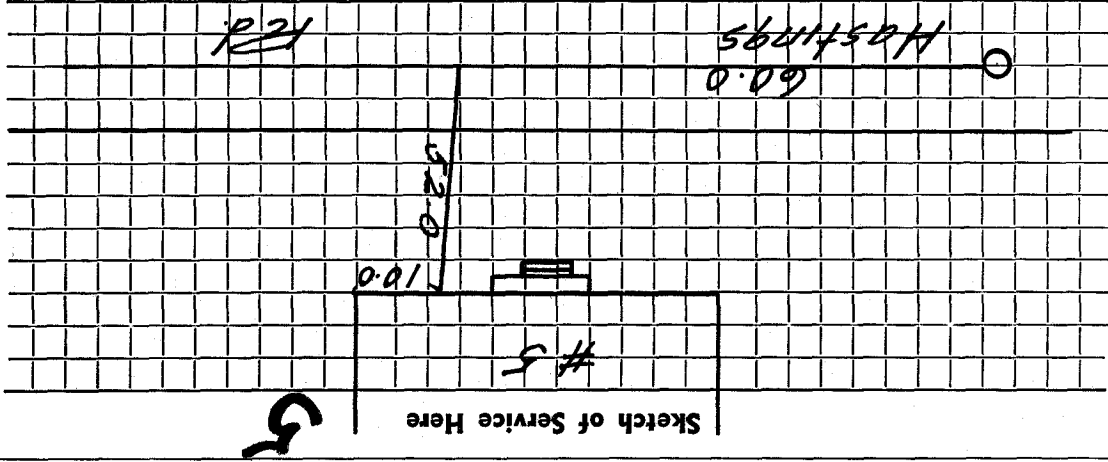

Connection made in Street.

Work completed

19..

Remarks: