

Name **William H. Ballard**

Address **7 Hastings Road,**

Service No. **104 363**

Location

Kind of Pipe

Size

Size of Main

~~Repair Sewer~~ **New Service**

Location

Date	Material	Amount	Total	Date	Amount
P. 2-5-29	60' 6" Clay Pipe @ .30	18 00			
76.27	1 4" Iron Y	1 37		Jan. 22 1929 - Cash	76 27
	1' 4" Pipe (Iron)	50			
	1 Brass Cap	40			
	1 6" x 1/4" Bend	70			
	1 6" x 1/8" "	70			
	Trucking	1 25			
	Sulphur & Jute	2 40	25 32		
2/23/70	Hrs. Labor @ .55	38 50			
5	" " @ .60	3 00			
4	" " @ .70	2 80	44 30		
	Labor 15% of		6 65		
10-27-98	Repair		6 27		
	24' 6" Sewer Pipe				
	1 6" Elbow				

Hadley Bros., Inc., Lexington

TOWN OF LEXINGTON—BOARD OF PUBLIC WORKS

SEWER DIVISION

DATE _____

The undersigned applies for the construction of a particular sewer connecting No. _____


Street and hereby agrees to comply with the Rules and Regulations governing the construction and use of Particular Sewers, as now or at any future time established by the Board of Selectmen.

Am't. of Estimate \$ _____

Am't. Paid \$ _____

Owner _____

Sketch of Service Here

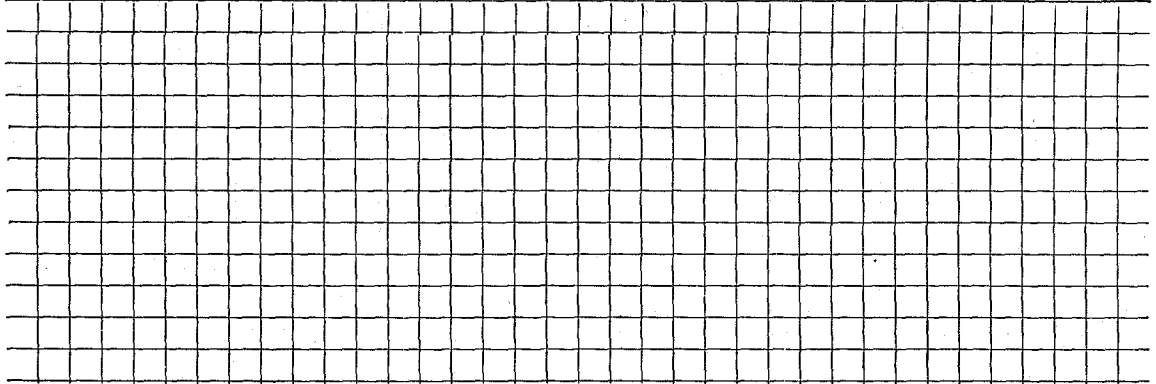

Connection made in _____

Street. _____

Work completed _____

19 _____

Remarks: