

Name *Marissa Ligiero*

Service No.

Address *25 Hathaway Road*

Location

Kind of Pipe *PVC*

Size *6"*

Size of Main

Repair—Renewal—New Service

Location

Date	Material	Amount	Total	Date	Amount
------	----------	--------	-------	------	--------

Ferco connection

1

Cleanout


1

6" SDR 35 pipe

DATE 5/16/18

TOWN OF LEXINGTON — BOARD OF PUBLIC WORKS
SEWER DIVISION

Sketch of Service Here

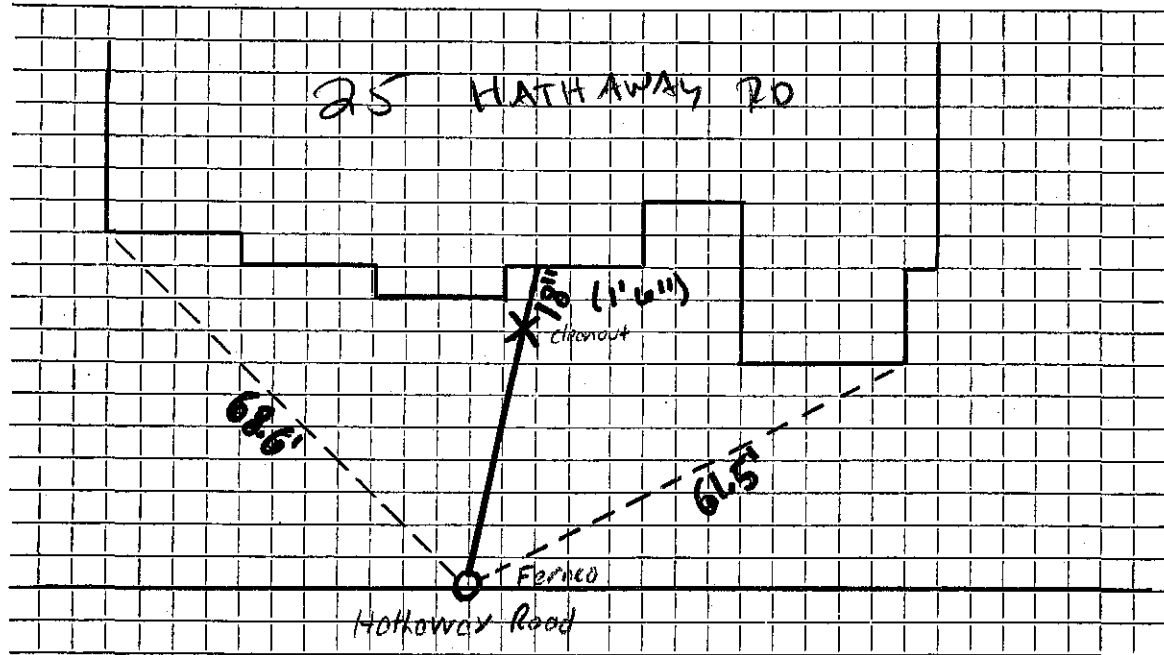

Connection made in ... Hathaway ... ~~Road Street~~ ... Work completed ... J. McLaughlin ...

Remarks:

.....

.....