


DATE 5/31/2018

TOWN OF LEXINGTON — BOARD OF PUBLIC WORKS
SEWER DIVISION

Sketch of Service Here

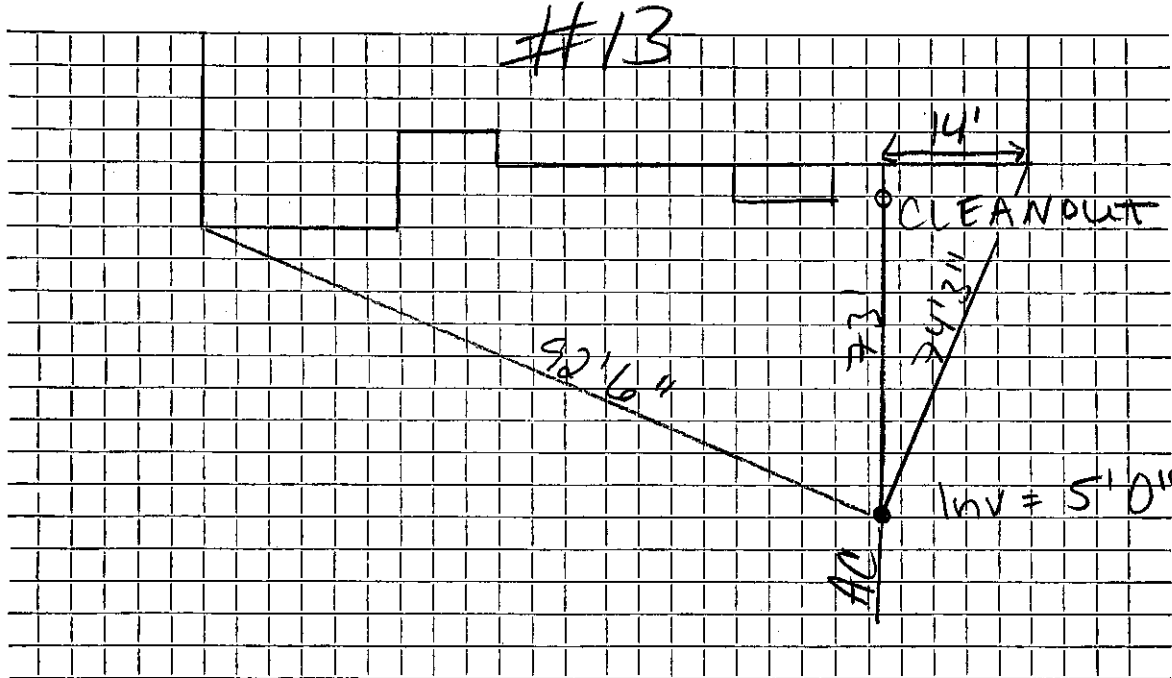

CLEANOUT
2'6" from
foundation

Connection made in Hathaway Street. Work completed

Remarks: