




TOWN OF LEXINGTON — BOARD OF PUBLIC WORKS

SEWER DIVISION

Sketch of Service Here

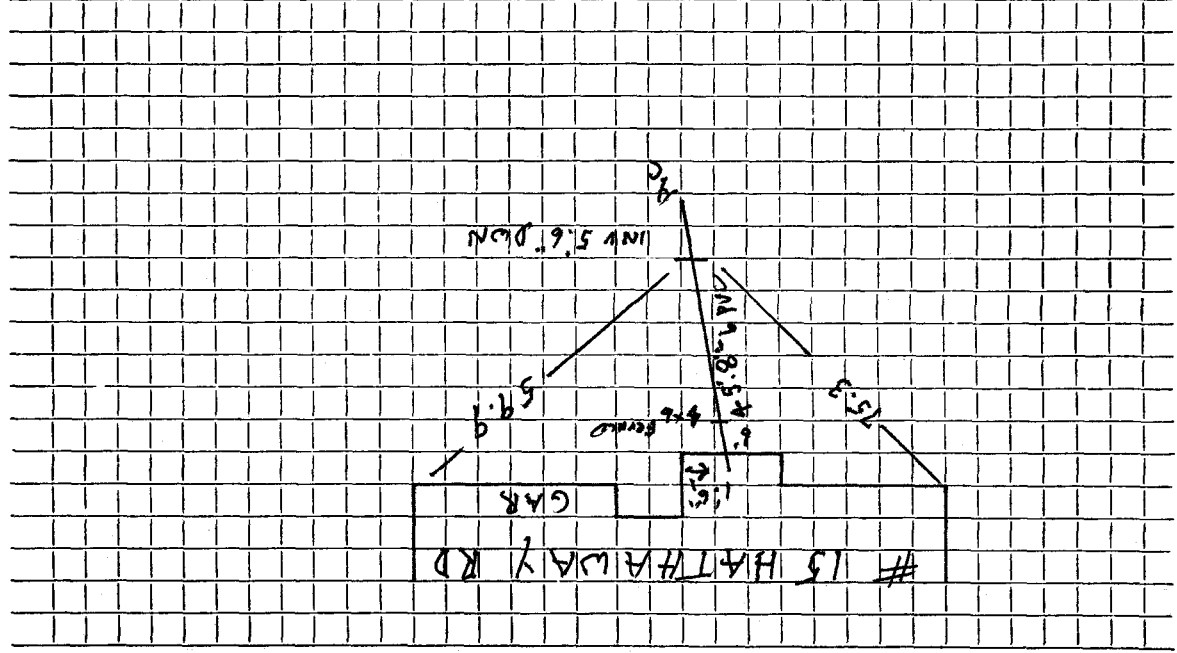

Work completed . 12/8/04

Street

Connection made in

Remarks: *lean down*