

Name

Contractor: D. Sauley

Service No.

Address

18 Hathaway Rd

Location

Kind of Pipe

SDR35 PVC

Size

6"

Size of Main

Repair

~~Renewal~~

New Service

Location

Date

Material

Amount

Total

Date

Amount

11/19/19

6" cleanout

6" SDR35 PVC

6" - 22° bend

6" - 22° bend


6" ferrodo

PVC to AC stub

DATE 11/19/2009

TOWN OF LEXINGTON — BOARD OF PUBLIC WORKS  
SEWER DIVISION

Sketch of Service Here

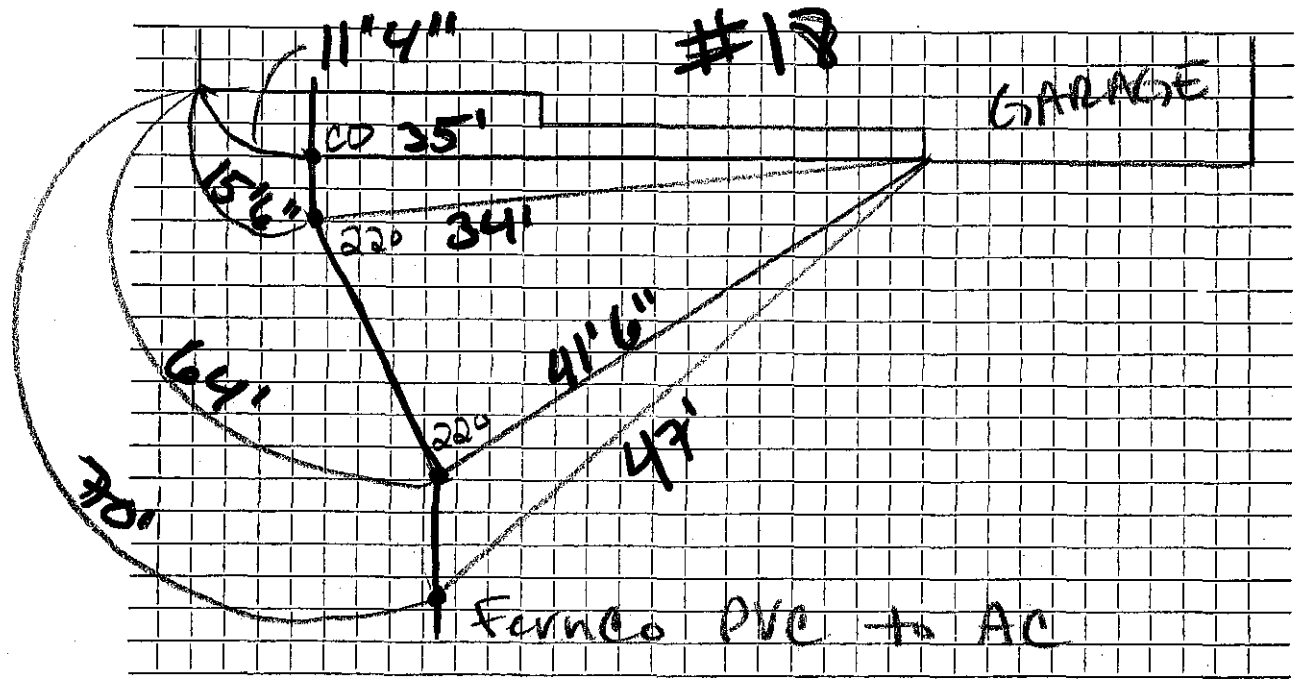

Connection made in Hathaway Rd Street. Work completed .....

Remarks: .....