



TOWN OF LEXINGTON — BOARD OF PUBLIC WORKS


SEWER DIVISION

DATE

5-3-94

22

Sketch of Service Here

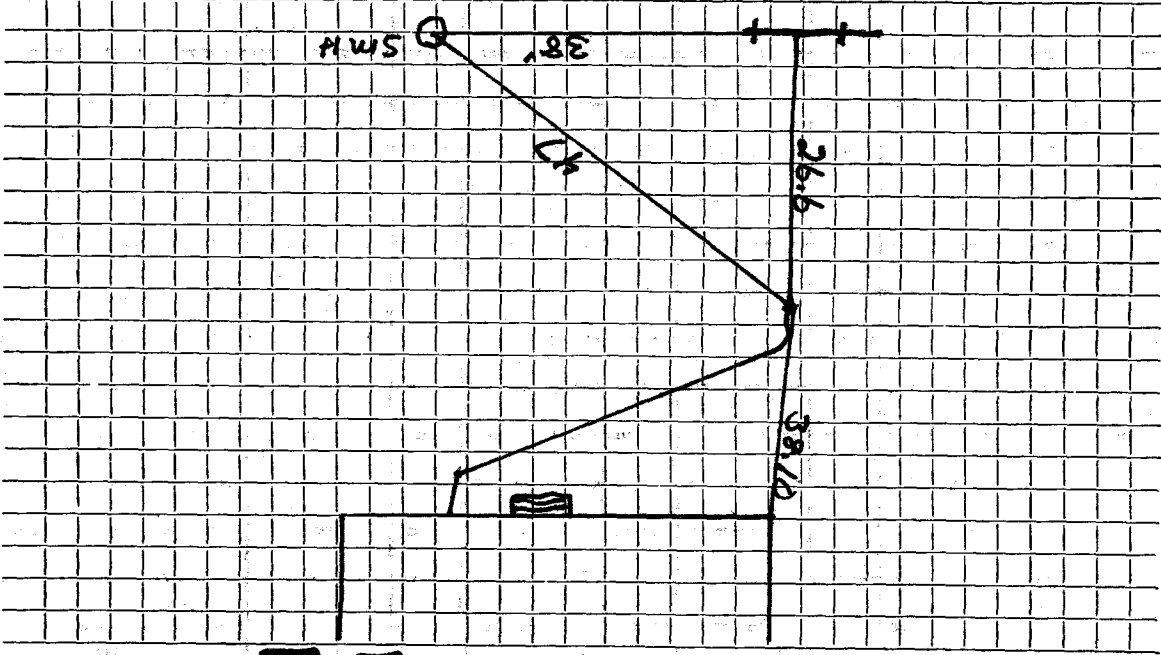

Connection made in

Street

Work completed

5-2-94

Remarks: Sewer about 7' deep @ curb

Water in same trench to the right of sewer

Origin of Service 11-25-58