

Name Esco Builders Corp.

Service No. 207

Address 29 Hathaway Road

Location Comm. 2/16/59

Kind of Pipe Size of Main

Repair--Renewal--New Service

Location

Date	Material	Amount	Total	Date	Amount
11/20/58	Labor	14 63		11/10/58	Deposit
10%	overhead	1 46	16 09	2/16/59	Refund
40'	6" Transite pipe @	.70	28 00		
1 hr.	Trucking		75		
4-10-59			44 84		
60'	6" Transite				
1	6"-11 1/4° Bend				
1	6"-22 1/2° Bend				
1	6" Adapter				
				9-24-65	Sewer Level
				9-16-65	Sludge in pipe
	Labor				Applied in total # 117
					" SHEET # 73 15.38
					" SHEET # 88 2.05
					" SHEET # 166 7.20


**TOWN OF LEXINGTON—DEPT. OF PUBLIC WORKS
SEWER DIVISION**

DATE.....
NO.....

The undersigned applies for the construction of a particular sewer connecting No.....
Street and hereby agrees to comply with the Rules and Regulations governing the construction and use of Particular
Sewers, as now or at any future time established by the Board of Selectmen.

Am't of estimate \$.....
Am't Paid \$.....

Owner.....

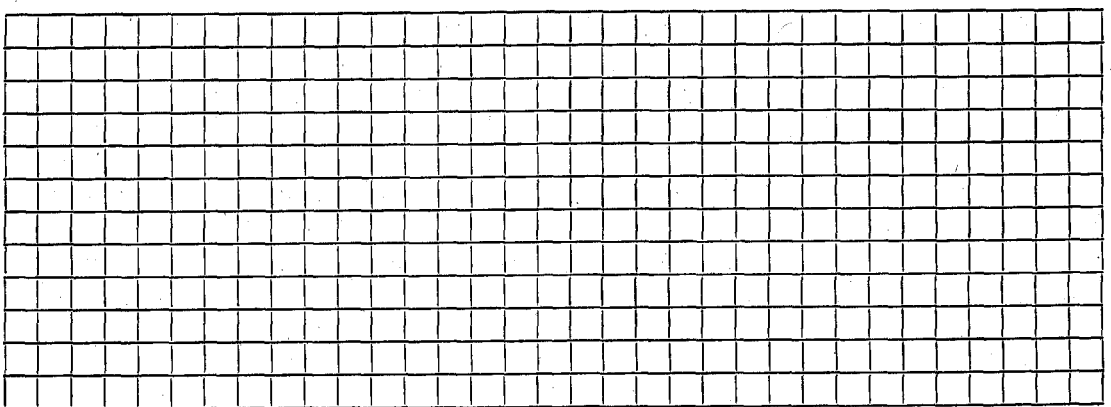

Sketch of Service Here

Connection made in..... Street.....
Work completed..... 19.....
Remarks: