


TOWN OF LEXINGTON — BOARD OF PUBLIC WORKS

SEWER DIVISION

DATE _____

Sketch of Service Here

131

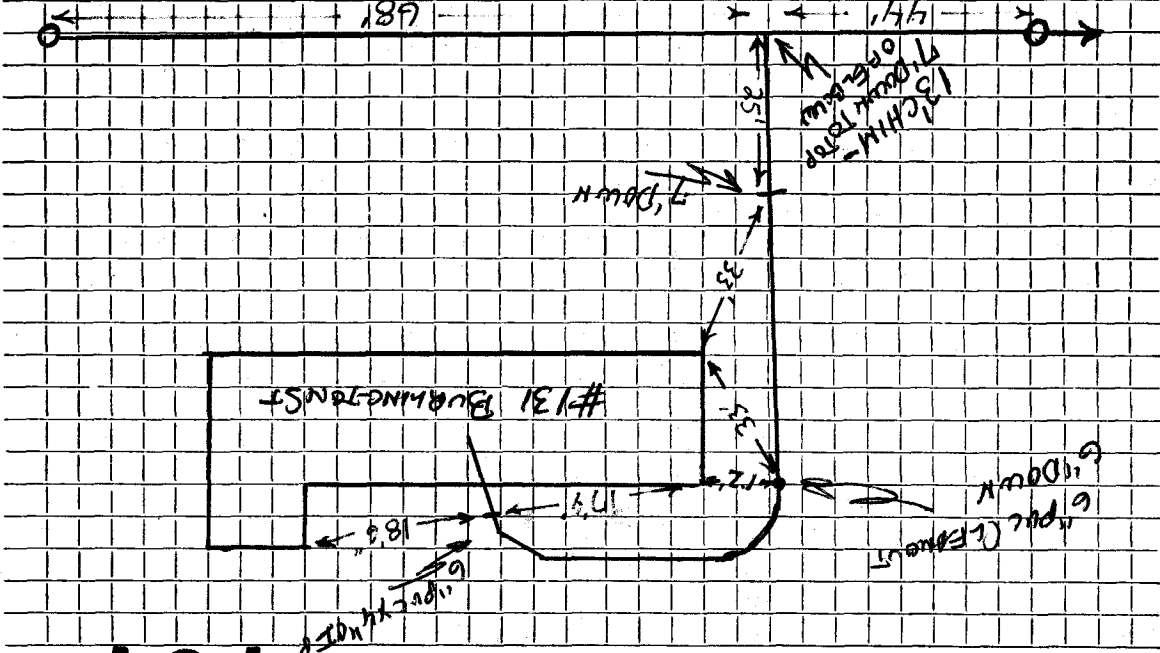

Connection made in Birmingham St. Street. Work completed. April 14, 1986

Remarks: