

Name Ralph Frisso

Service No. 106

Address # 4 Hawthorne Rd.

Location

Kind of Pipe

Size

Size of Main

~~Renewal~~ New Service W.O. #3029 Suburbanite #A 371

Location OCT 3 1966


Date	Material	Amount	Total	Date	Amount
8/11/66	Labor 49.09			8-1-66	135.00
8/12/66	Patching 17.87	66.96		10-7-66	15.87
	10% O.H.	6.70	73.66	8-11-66	140.87
20 1	6" Transite pipe @.88		17.60	20' 6" Transite	
1	6" adapter		1.08	1 6" Adapter	
1	6" Nipple		.91	1 6" Nipple	
1	6" Transite Elbow		4.09	1 6" Elbow	
1	22 1/2 Transite Band		4.09	1 6"-22 1/2 Bend	
1	22 1/2 Transite Elbow		2.35	1 6"-22 1/2 Elbow	
1	Collar		4.09		
4	hrs. Truck @3.00		12.00		
2	hrs. Shovel @6.50		13.00		
2	hrs. Loader @4.00		8.00		
			140.87		
8/12/66	30' 6" Transite pipe				
10'	4" Cast Iron Pipe				

TOWN OF LEXINGTON — BOARD OF PUBLIC WORKS

SEWER DIVISION

DATE _____

Sketch of Service Here

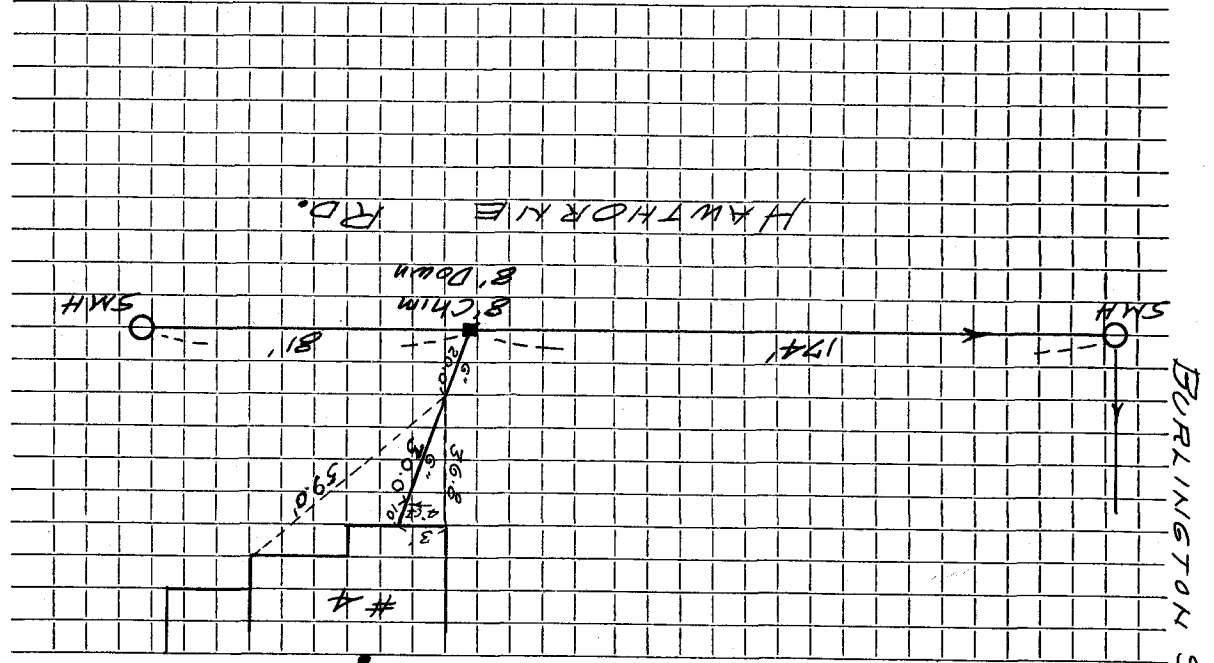

Connection made in _____ Street. Work completed _____

Remarks: _____