

Name David Sampson

Service No. 187

Address # 5 HAWTHORNE RD.

Location

Kind of Pipe

Size

Size of Main

Repaired/Removed - New Service

W.C. # 7221

Location

Clearance 1-14-63

Date	Material	Amount	Total	Date	Amount
11-26-62	Labor	95.97		11-9-62	300.00
	10% O.H.	9.60	105.57	1-14-63	23.33
50'	6" Transite pipe @.82		41.00		297.67
6	ton Bank Gravel @.85		5.10		
3	ton 1 1/4" Stone @1.50		4.50		
1	11 1/2" Transite Bend		4.09		
1	6" Transite Nipple		.91		
3	hrs. Town Shovel @6.50		19.50		
3	hrs. Trucking @3.00		9.00		
1	hr. Trailer @3.00		3.00		
1	hr. Loader @5.00		5.00		
12 x 20	Patch		80.00		
	Spring Loam & Seed		20.00		
			297.67		


TOWN OF LEXINGTON — BOARD OF PUBLIC WORKS

SEWER DIVISION

DATE _____

5

Sketch of Service Here

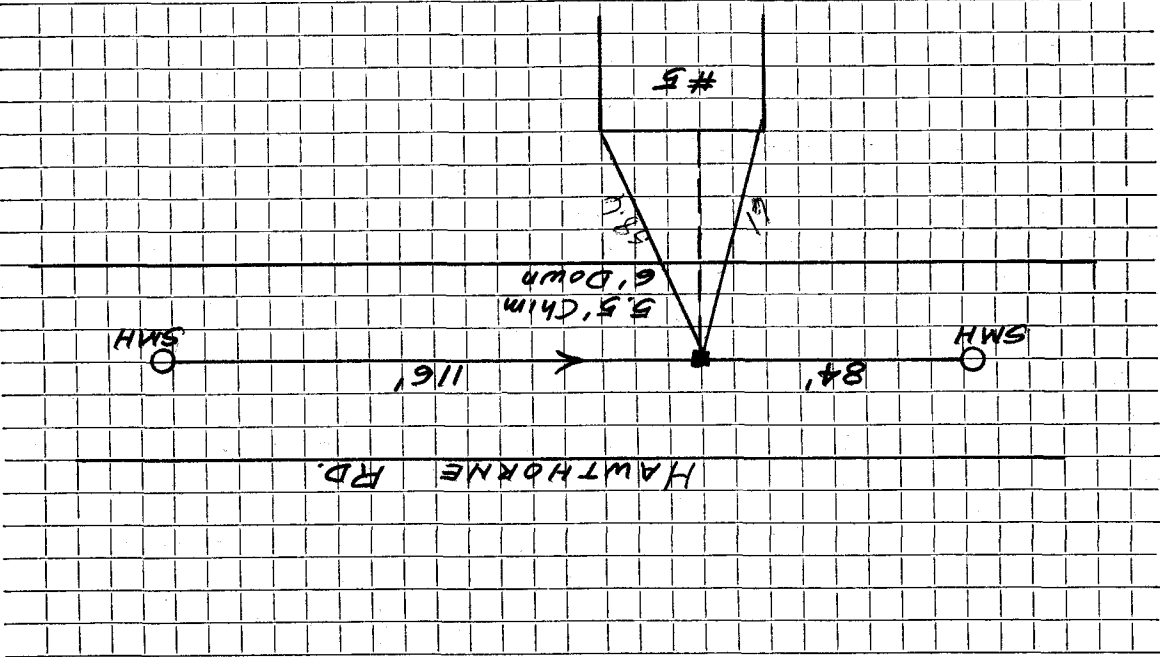

Connection made in Street. Work completed
Remarks: