

Name George Colby Jr.

Service No. 188

Address # 7 HAWTHORNE RD.

Location

Kind of Pipe

Size

Size of Main

~~Renewal~~ New Service

W.C. # 2222

Location

1-14-63

Date	Material	Amount	Total	Date	Amount
11-28-62	Labor	108.07		11-9-62	
	10% O.H.	10.81	118.88	1-14-63	
	54' 6" Transite pipe @.82		44.28		
	12 ton 3/4" Stone @1.50		18.00		
	1 90° Transite Elbow		4.09		
	1 6" Transite Nipple		.91		
	4 hrs. Town Shovel @6.50		26.00		
	2 hrs. Trucking @3.00		6.00		
	14 x 3 Patch		14.00		
	Spring Loam & Seed		20.00		
			252.16		

Deposit
Refund


TOWN OF LEXINGTON — BOARD OF PUBLIC WORKS

SEWER DIVISION

DATE _____

7

Sketch of Service Here

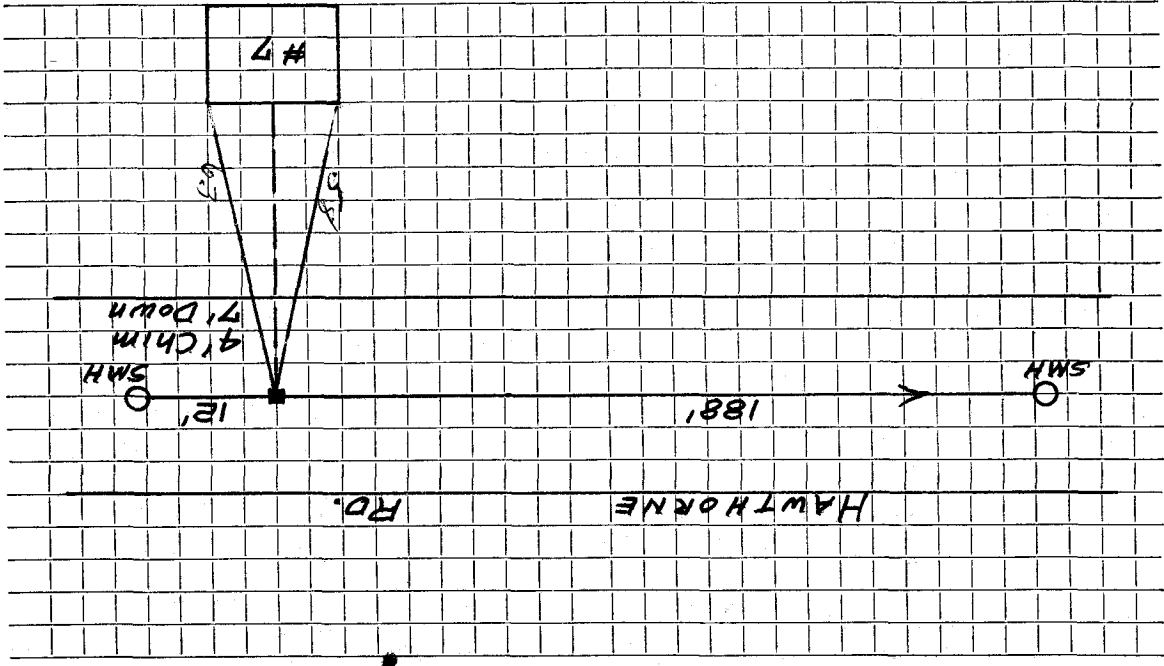

Work completed

Street.

Connection made in

Remarks: