

Name

Mrs. Camille Skove

Service No. 183

Address # 8 HAWTHORNE RD.

Kind of Pipe

Size

Location

Size of Main

~~Repaired~~ Renewals - New Service

DEC 22 1963

Location

CH 1-1463

Date	Material	Amount	Total	Date	Amount
11-23-62	Labor 54.48			11-6-62	Deposit
11-24-62	" 118.04	172.52		7-10-64	Paid
	10% O.H.	17.25	189.77		
52' 6"	Transite pipe @.82	42.64	42.64		NON CHARGE
6 1/2 ton	1 1/2" Stone @1.50	9.37	9.37	11-24-62	Labor
1	90° Transite Elbow	4.09	4.09		Patch
1	6" Transite Nipple	.91	.91		
8	hrs. Town Shovel @6.50	52.00	52.00		
4	hrs. Trucking @3.00	12.00	12.00		
6	hrs. Pumping @1.00	6.00	6.00		
17	x 20 Patch	50.00	50.00		
	Spring Loam & Seed	20.00	20.00		
		386.78	386.78		
		122.35	122.35		
		509.13	509.13		
					Bill sent
					136.28


TOWN OF LEXINGTON — BOARD OF PUBLIC WORKS

SEWER DIVISION

DATE _____

Sketch of Service Here

8

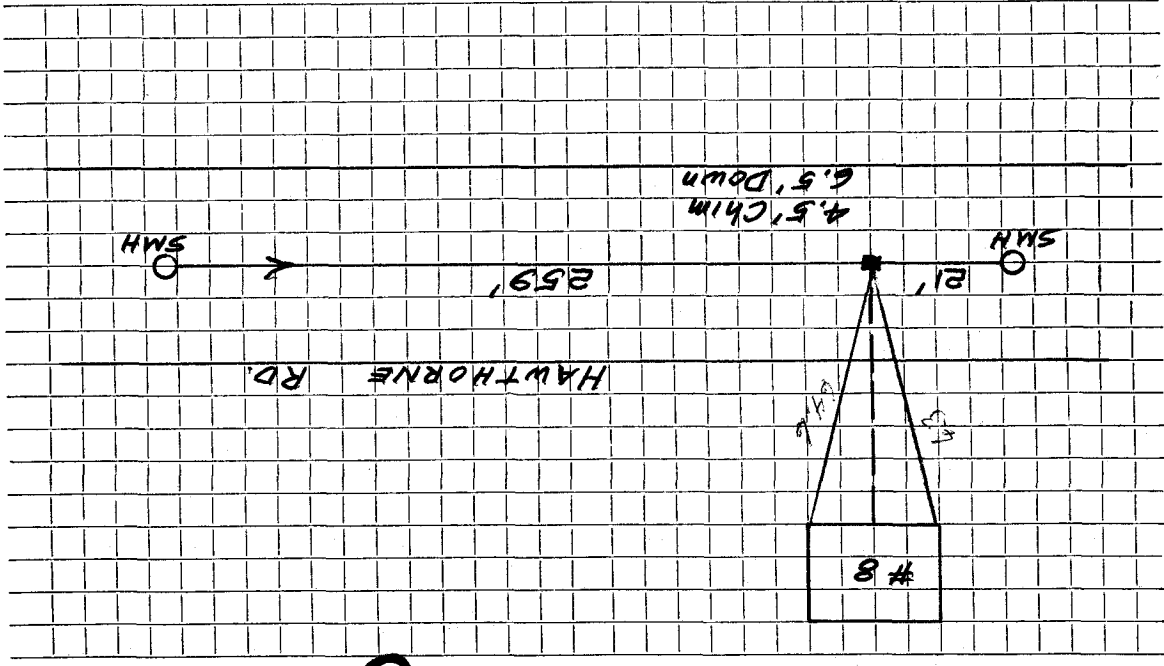

Work completed

Street.

Connection made in

Remarks: