




DATE 7/12/18

TOWN OF LEXINGTON — BOARD OF PUBLIC WORKS  
SEWER DIVISION

Sketch of Service Here

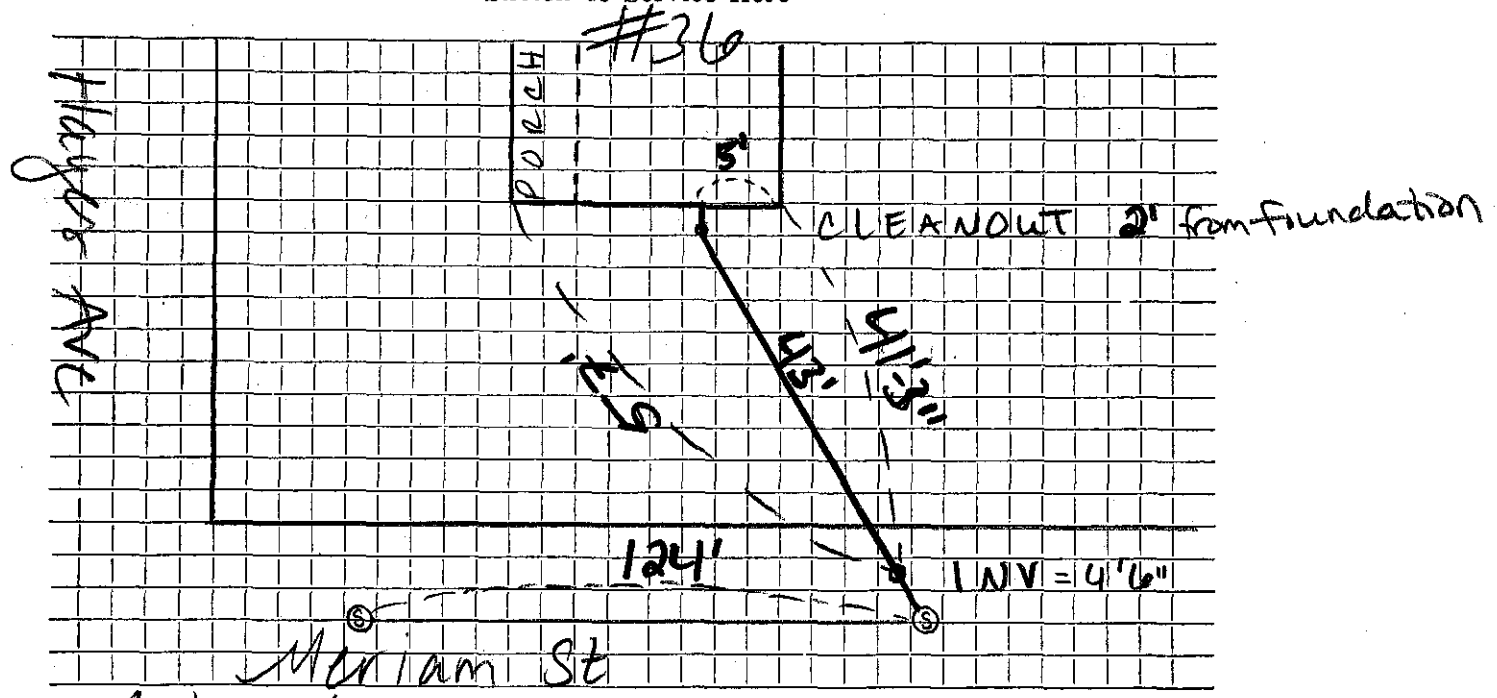

Connection made in Meriam St Street. Work completed .....

Remarks: #36 Hayes Ave new connection in Meriam St