

Name

Service No.

Address 44 HAYES AVE

PERMANENT

Location

Kind of Pipe

Size

Size of Main

Repair—~~Renewal~~—New Service

Location

Date

Material

Amount

Total

Date

Amount

4/20

6" SDP

6" CLEAN OUT

• 6" CAP


• 6" TEE W/UT

• 6" SDP PUCK

DATE 4/2017

TOWN OF LEXINGTON — BOARD OF PUBLIC WORKS
SEWER DIVISION

Sketch of Service Here

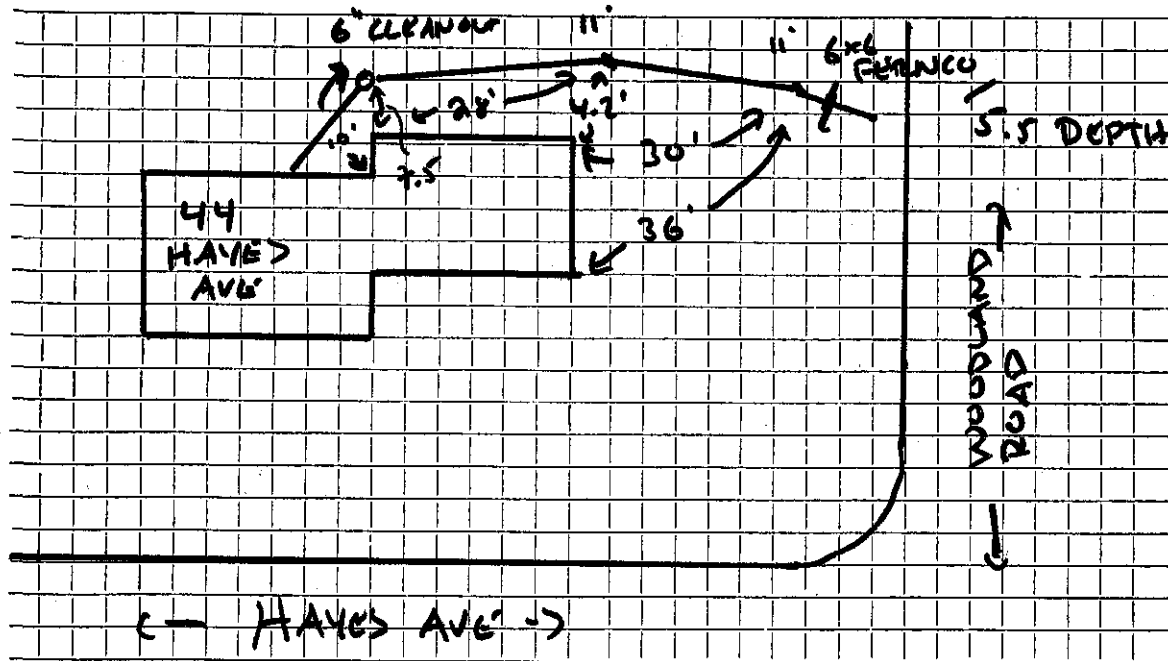

Connection made in WOODLAND Street. Work completed FURNANTH CONSTRUCTION

Remarks:

.....

.....