




TOWN OF LEXINGTON — BOARD OF PUBLIC WORKS

SEWER DIVISION

Sketch of Service Here

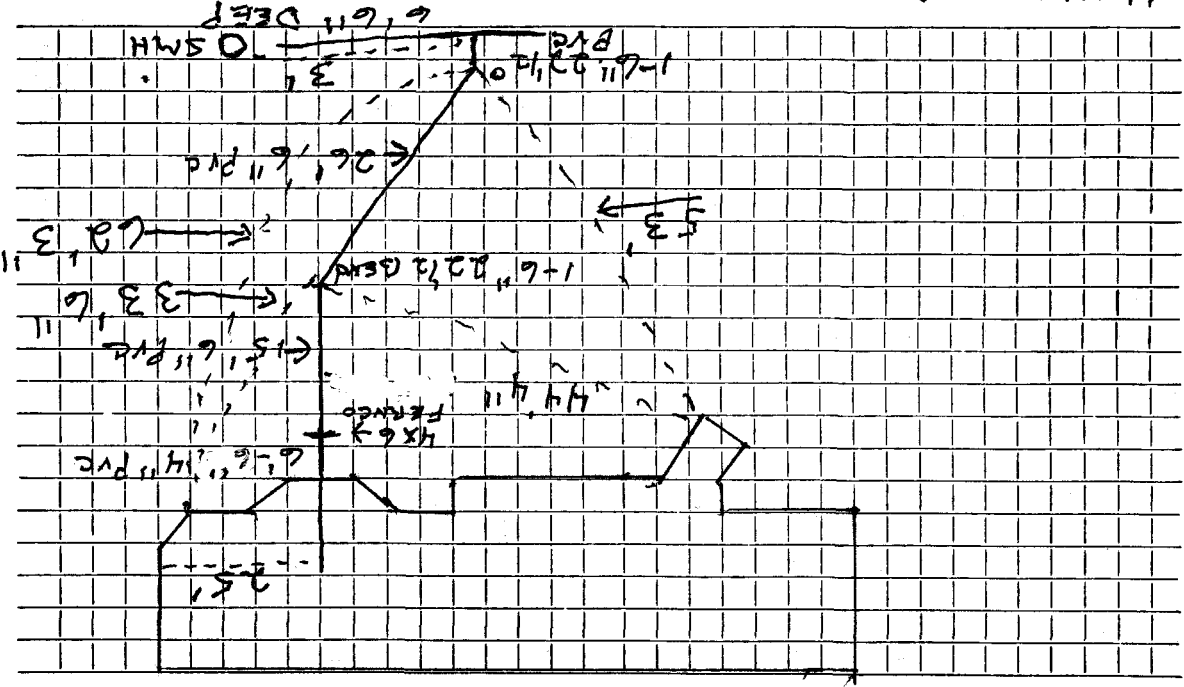

Connection made in HAYES AVE Street.

Work completed

Remarks: INSTALLED BY T. H. LAUGHLIN

DATE June 4, 2001