

Name

Service No.

Address

2 Hayes Ave

Location

Kind of Pipe

SDR Sch. 35 PVC

Size

6"

Size of Main

Repair—Renewal

New Service

Location

Date

Material

Amount

Total

Date

Amount

July 2021

6" Cleanout


6" PVC pipe

6" ferrule

DATE July 2021

TOWN OF LEXINGTON — BOARD OF PUBLIC WORKS
SEWER DIVISION

Sketch of Service Here

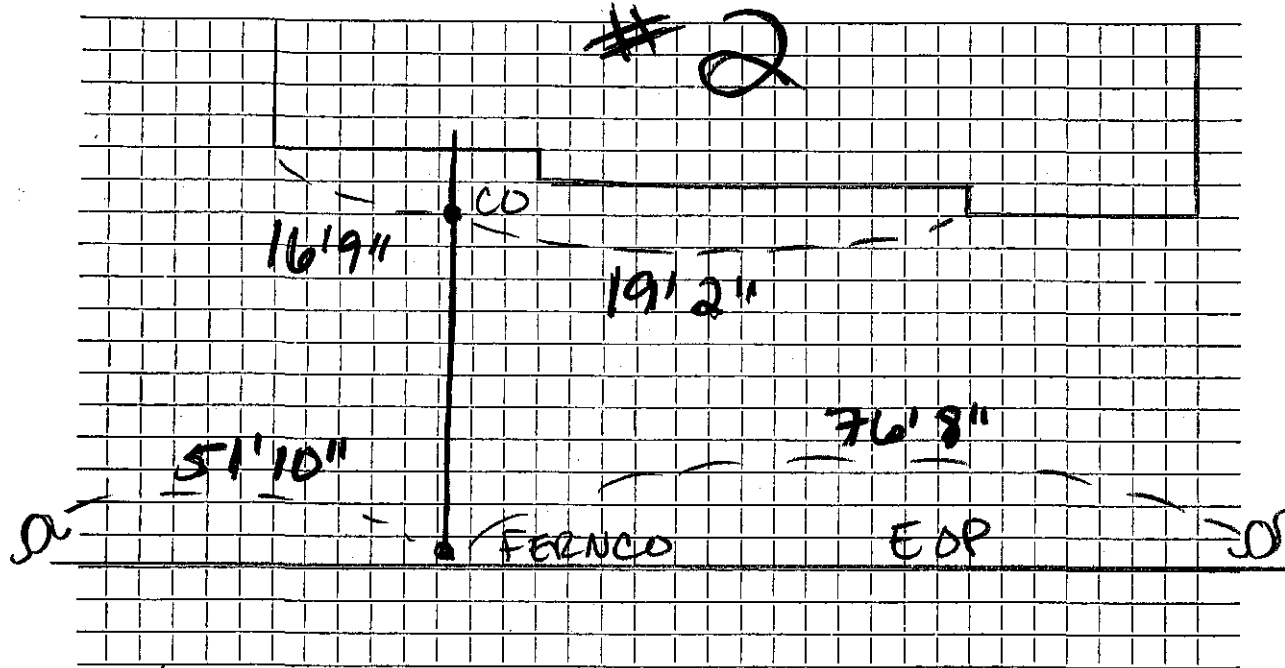

Connection made in Hayer Ave Street. Work completed

Remarks:
.....
.....