




DATE \_\_\_\_\_

# TOWN OF LEXINGTON — BOARD OF PUBLIC WORKS

## SEWER DIVISION

Sketch of Service Here

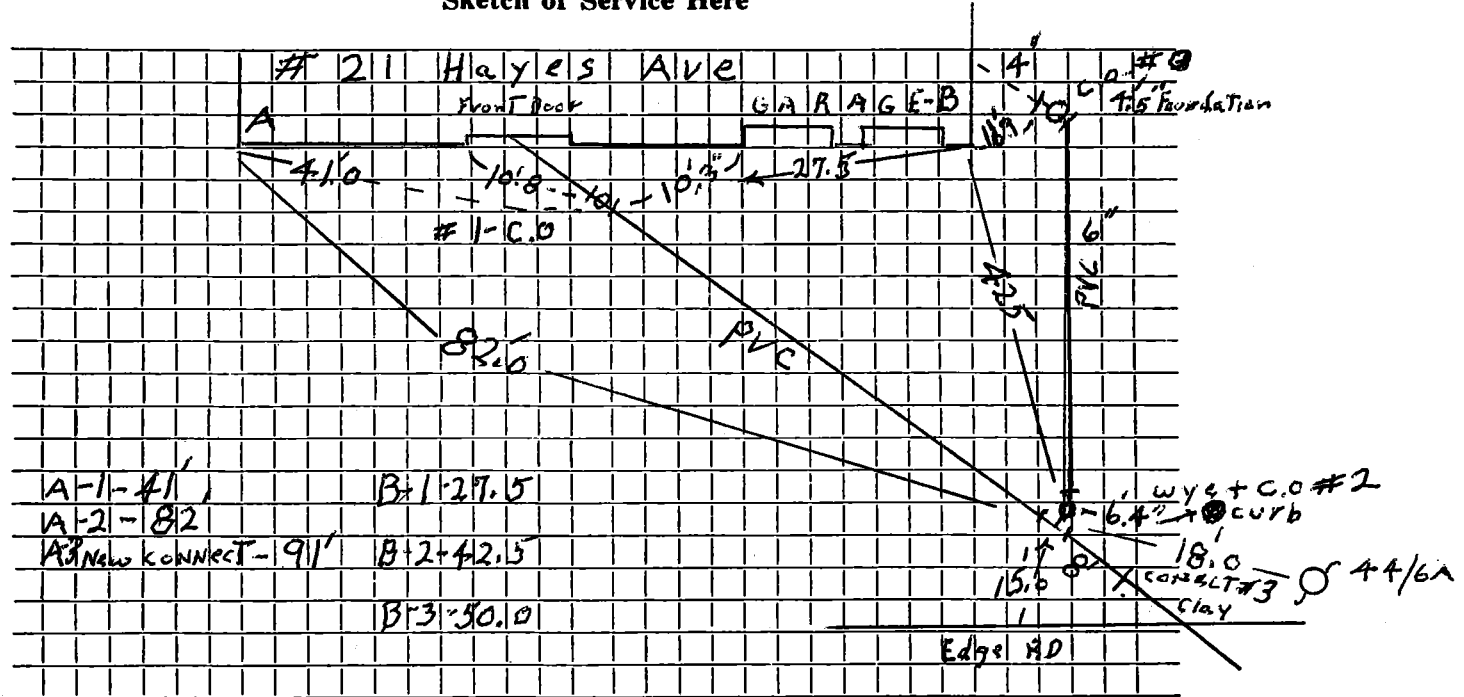

A-1-41'	B-1-27.5'
A-2-82'	B-2-42.5'
A-3-NEW CONNECT-91'	B-3-50.0'

Connection made in ..... Street. Work completed 2011 - Redmond .....

Remarks: 1950 - Clay IN ST. ....

.....

.....