

Name Truman S. Gray

Service No. 51

Address 22 Hayes Avenue

Location

Kind of Pipe

Size

Size of Main

~~REPAIR/RENEWAL~~ New Service Valeri Const. Permit #A256 - W.O.#2174

Location JUN 27 1966

Date	Material	Amount	Total	Date	Amount
4-29-66	Labor 54.80			4-26-66	100 00
5-19-66	Patching 43.09	97 89		2-6-66	90 35
	10% O.H.	9 79	107 68		
27'	6" Transite pipe @.82		22 14		
1	90° Elbow		4 09		
15	Brick @ 4.20 per 100		64		
1	Bag Cement		1 55		
1	Ton cold patch		5 00		
2	Ton hot top @ 5.50		11 00		
4 1/2	Hrs. Truck @ 3.00		12 75		
2	Hrs. Shovel @ 6.50		13 00		
2	Hrs. Compressor @ 5.00		10 00		
1 1/2	Hr. Roller @ 3.00		1 50		
1 1/2	Hr. Trailer @ 2.00		1 00		
			190 35		
6-25-66	32' 6" Transite pipe				

Deposit
Paid


Bill sent 2035

TOWN OF LEXINGTON — BOARD OF PUBLIC WORKS

SEWER DIVISION

DATE _____

Sketch of Service Here
22

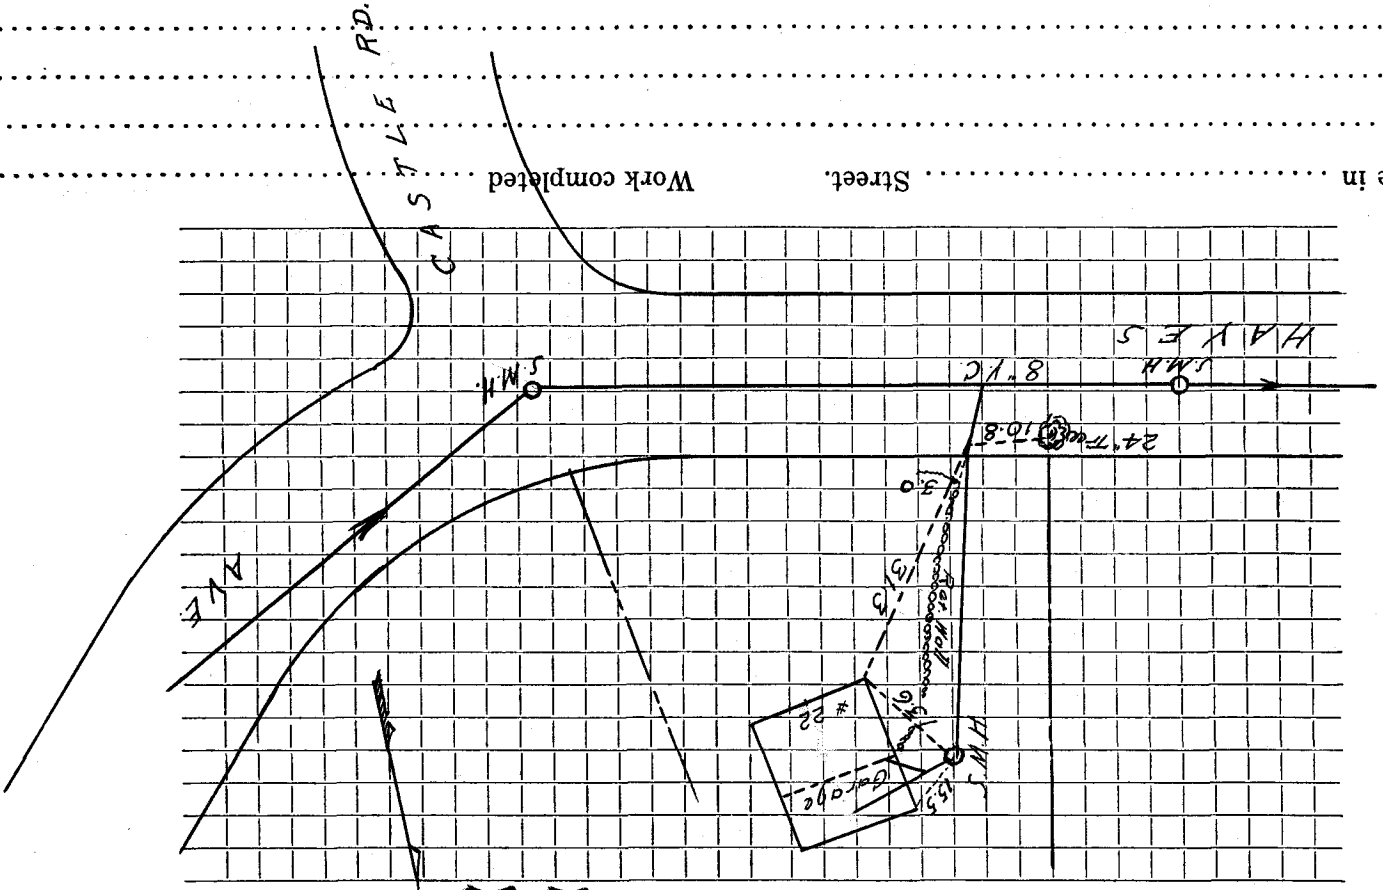

Connection made in _____ Street.

Work completed

Remarks: _____