




TOWN OF LEXINGTON — BOARD OF PUBLIC WORKS

SEWER DIVISION

DATE

6/1/94

Sketch of Service Here  
24

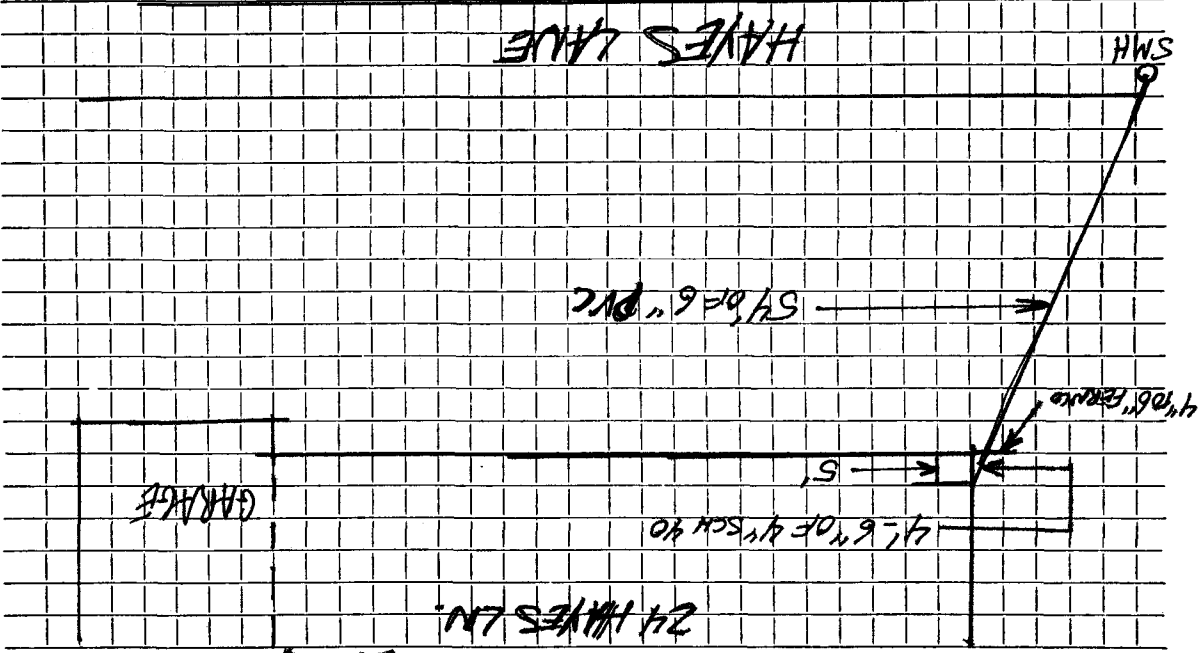

Connection made in ..... Street. Work completed .....  
Remarks: .....