

Name

John C. Kent

Service No.

148

Address

31 Hayes Avenue

Location

Kind of Pipe

Size

Size of Main

Repairs ~~Renewal~~ - New Service W.O. #3670 Sibley #481

Location OCT 9 1967

Date	Material	Amount	Total	Date	Amount
12/16/66	Labor	44.22		11-15-66	Deposit
5/10/67	Labor	28.67	72 89	11-6-67	Paid
	10% O.H.		80 18	12-16-66	
	18' 6" Transite pipe @ .88		15 84	18'	6" Transite
	1 1 1/4" Sweep		2 35	1	6"-11 1/4" Sweep
	1 Cap		1 63		
	3 Couplings @ 1.53		4 59		
	1/4 Bag Cement @ 1.55		39		
	2 Ton Cold Patch @ 5.00		10 00		
	2 Ton Hot top @ 5.50		11 00		
	2 Hrs. Shovel @ 6.50		13 00		
	7 Hrs. Trucking @ 3.00		21 00		
	1 Hr. Compressor		5 00		
	1/2 Hr. Roller @ 3.00		1 50		
			166 48		
10-27-67	51' 6" Transite pipe				
	10' 4" Cast Iron pipe				

Bill 522 41.48


TOWN OF LEXINGTON — BOARD OF PUBLIC WORKS

SEWER DIVISION

DATE _____

31

Sketch of Service Here

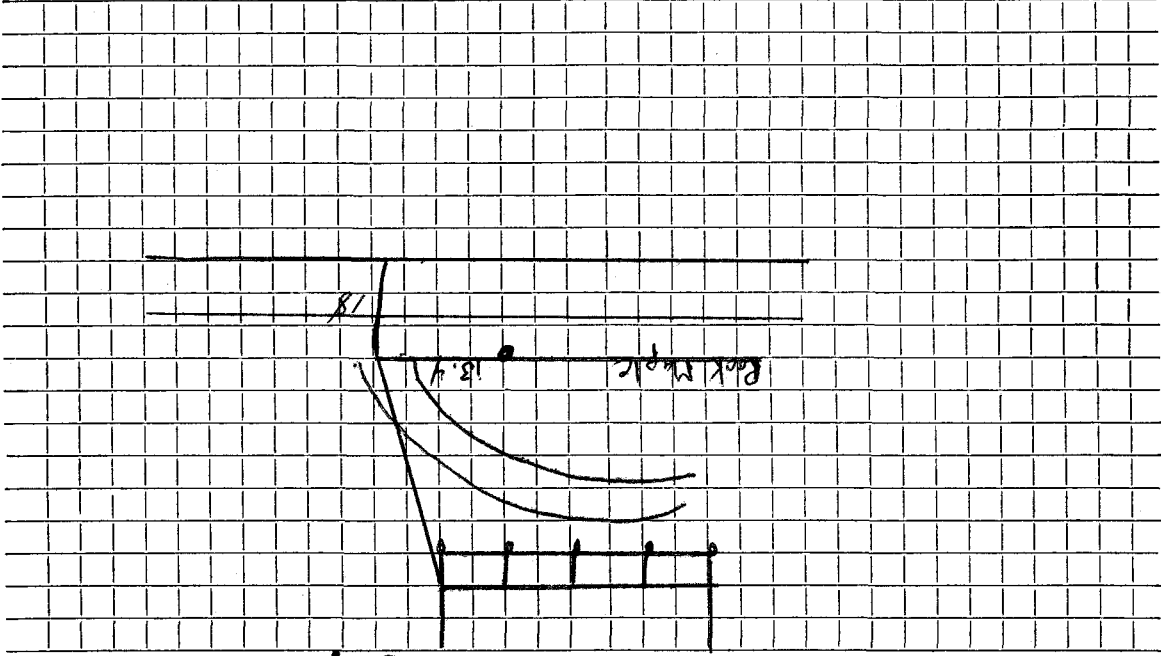

Connection made in Street. Work completed

Remarks: