

Name

Speedwagon

Service No.

Address

53 Hancock St → Now to Hayer Avenue

Location

Kind of Pipe

SDR35 PVC

Size

6"

Size of Main

Repair

~~Renewal~~

New Service

Location

Date

Material

Amount

Total

Date

Amount

10/27/2020

saddle connection
to main w/
22° bend

6" SDR35 PVC 115' 6"
+ 48' 8"


6" PVC cleanout

new sewer manhole

DATE 10/28/2020

TOWN OF LEXINGTON — BOARD OF PUBLIC WORKS
SEWER DIVISION

Sketch of Service Here

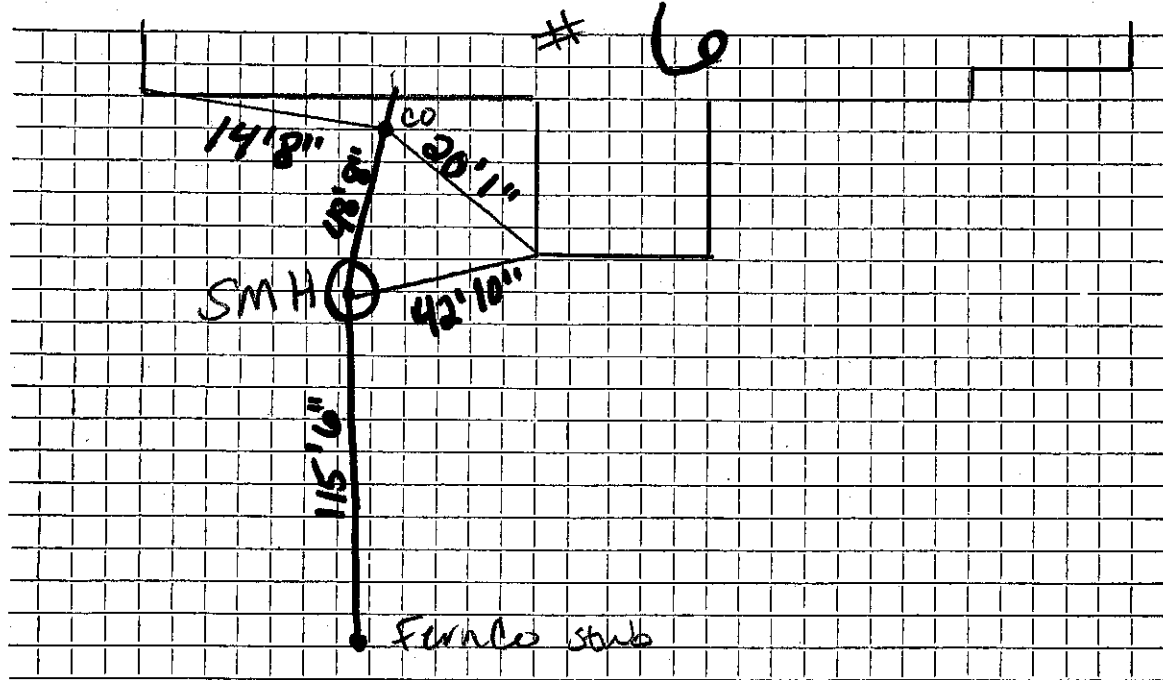

Connection made in Hayer Ave Street. Work completed

Remarks:
.....
.....