




DATE 6/23/00

TOWN OF LEXINGTON — BOARD OF PUBLIC WORKS

SEWER DIVISION

Sketch of Service Here

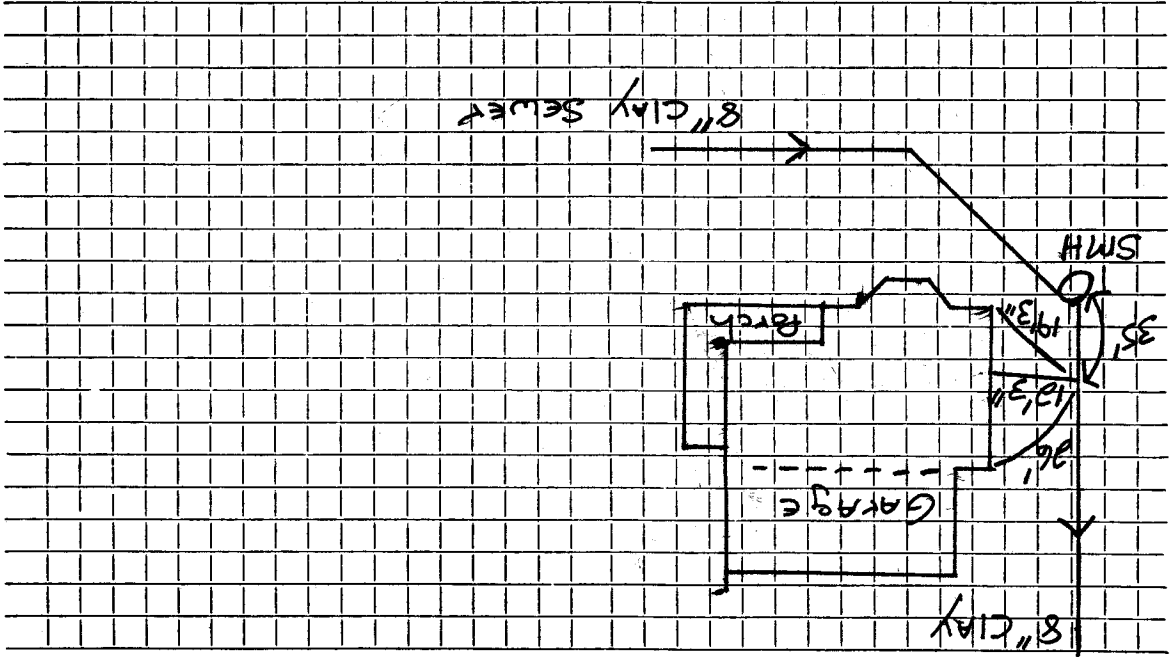

Work completed

Street.

Connection made in

Remarks: Sewer Down 4'6" into easement