

Name

Service No.

Address

12 Hayes Ln

Location

Kind of Pipe

Size

Size of Main

Repair—Renewal—New Service

Location


Date	Material	Amount	Total	Date	Amount
4-28-03	4x6 PVC to PVC	for service			
	6x6 PVC to Clay	for service			
	8' - 4" PVC				
	Ø8' - 6" PVC				

TOWN OF LEXINGTON — BOARD OF PUBLIC WORKS

SEWER DIVISION

DATE _____

Sketch of Service Here

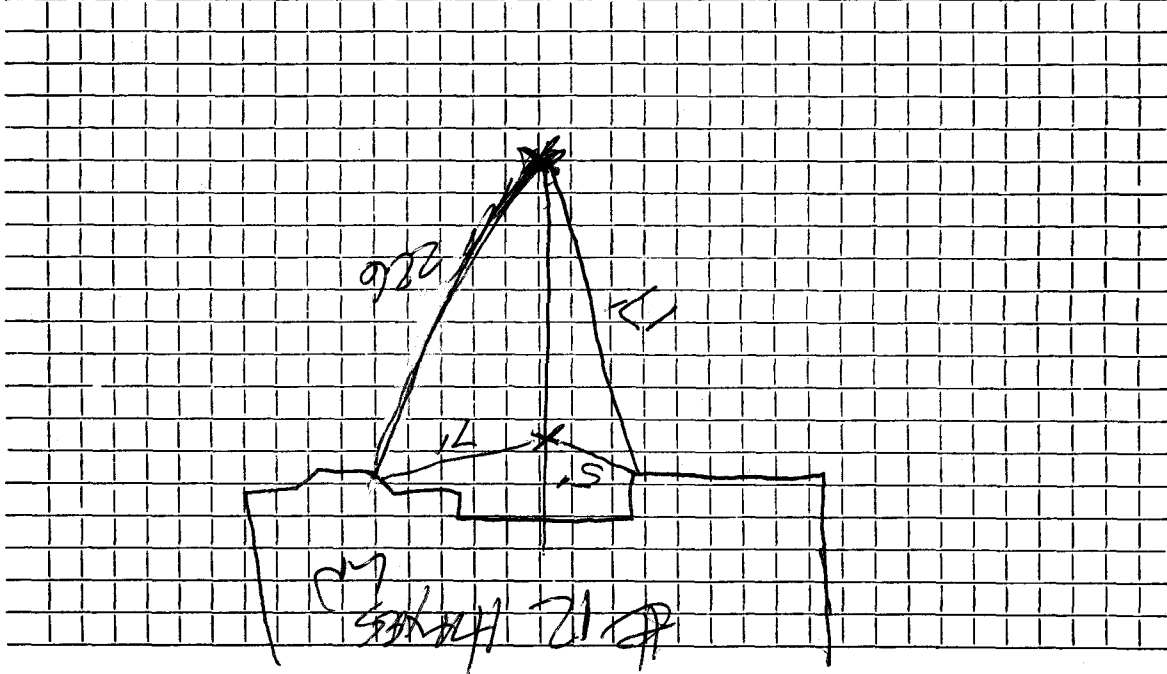

Work completed

Street - Service extended to main

Connection made in

Remarks: