


TOWN OF LEXINGTON — BOARD OF PUBLIC WORKS

SEWER DIVISION

DATE _____

Sketch of Service Here

15

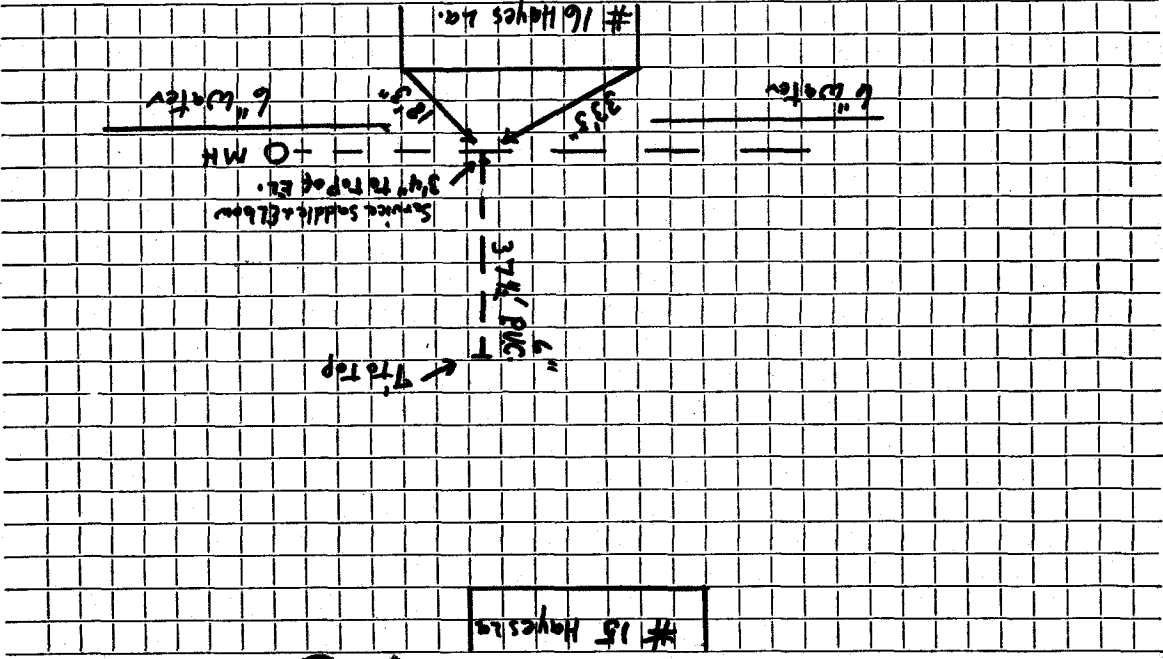

15 Haystack

16 Hayes Ln.

Connection made in front yd of 16 Hayes Ln. Street.

Work completed

Remarks: Gas - water & sewer in same easement.