




DATE \_\_\_\_\_

**TOWN OF LEXINGTON — BOARD OF PUBLIC WORKS**  
**SEWER DIVISION**

Sketch of Service Here

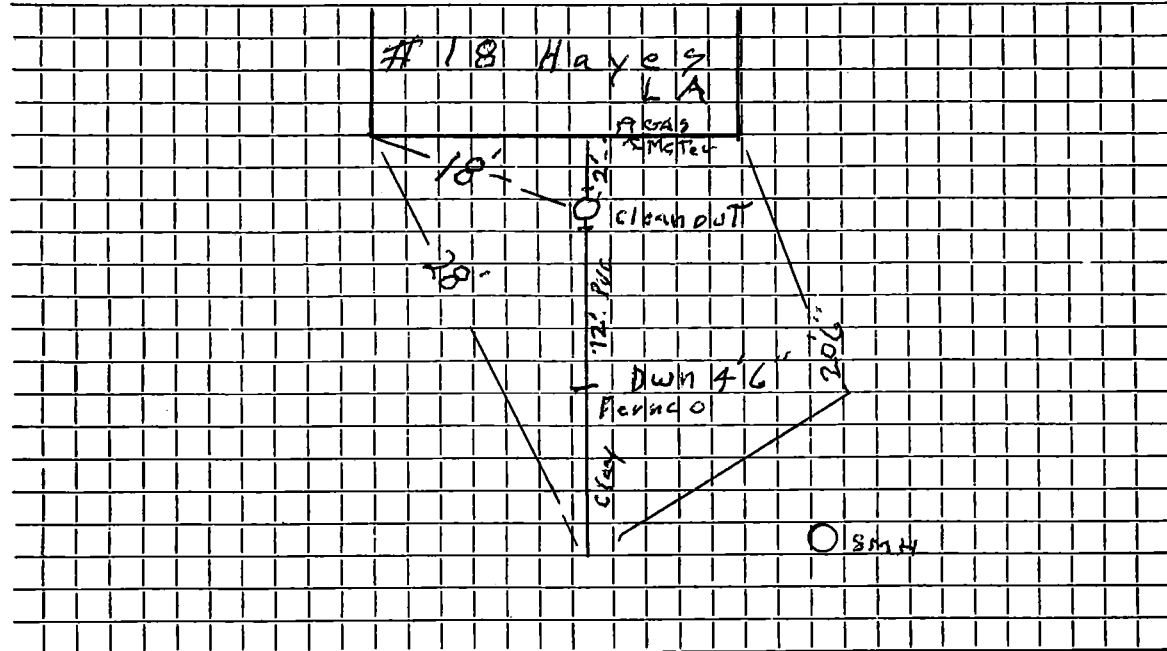

Connection made in ..... Street. Work completed 11/16/10 Paul Ross.....  
Remarks: 20.6 - 28' is off old Tie Card. Sewer goes in by Gas meter.....  
.....  
.....