

Name George R. Limbrick Jr.

Service No. 189

Address 23 Hayes Lane

Location

Kind of Pipe Size of Main

~~Repair~~ Renewal—New Service W.O. #6022 Location AUG 5 1968

Date	Material	Amount	Total	Date	Amount
10-19-67	17' 6" Transite pipe			12-18-68	200 00
12/28/67	22' 4" Cast Iron pipe Labor	71 00		8-5-68	86 27
	10% O.H.	7 10	78 10		113 73
	25' 6" Transite pipe @ .88		22 00		
	½ Bag Cement @ 1.55		78		
	1 1½ Bend		2 35		
	1 Hr. Shovel		6 50		
	1 Hr. Loader		4 00		
			113 73		


TOWN OF LEXINGTON — BOARD OF PUBLIC WORKS

SEWER DIVISION

DATE _____

23

Sketch of Service Here

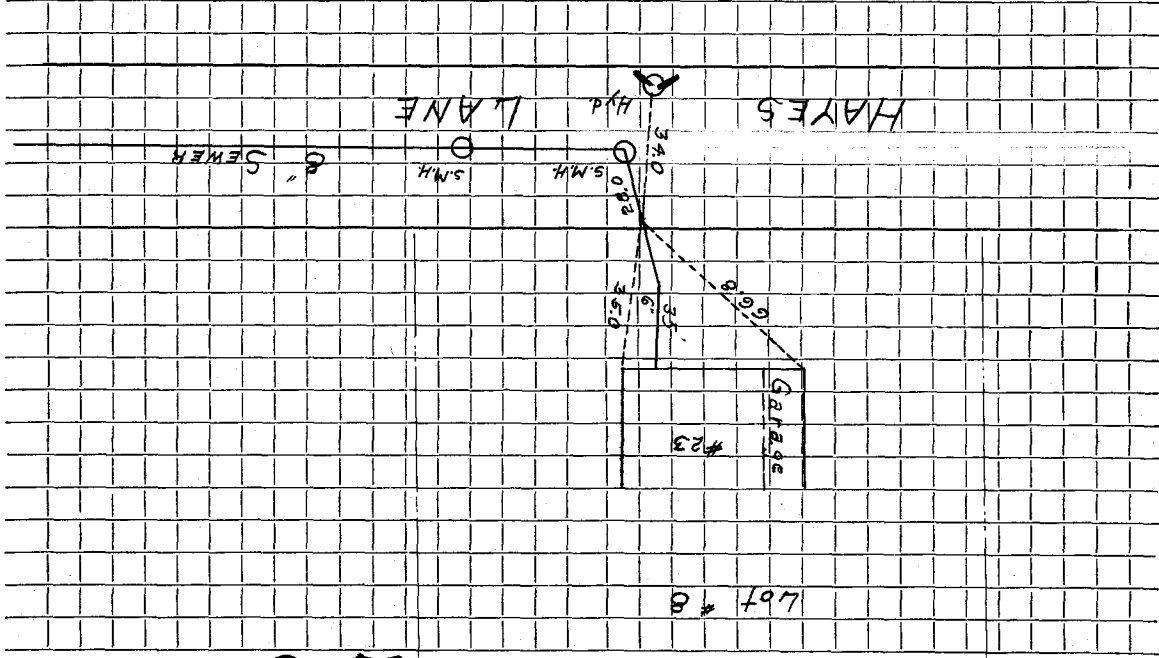

Work completed

Street

Connection made in

Remarks: