


SEWER DIVISION

Sketch of Service Here
 26

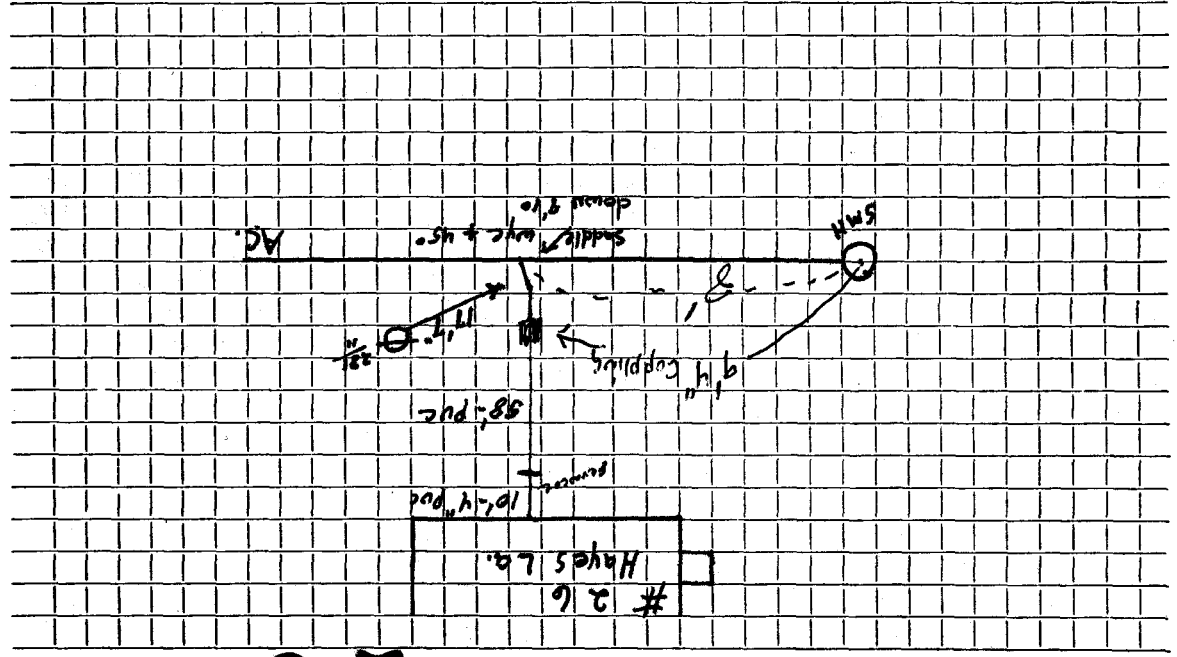

Connection made in Street. Work completed
 Remarks: