

TOWN OF LEXINGTON — BOARD OF PUBLIC WORKS


SEWER DIVISION

DATE _____

Sketch of Service Here

29

Ho. # 29
Hayes Lane

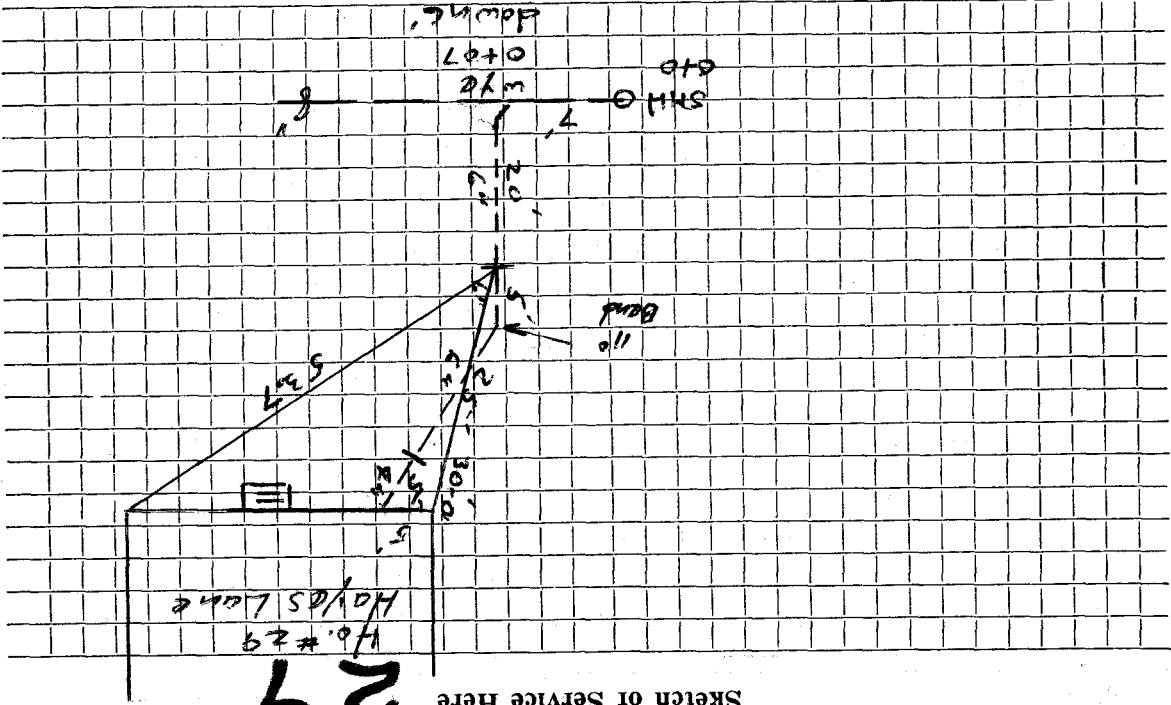

Connection made in Hayes Lane

Street.

Work completed

Remarks: