


DATE 8/31/23

TOWN OF LEXINGTON — BOARD OF PUBLIC WORKS

SEWER DIVISION

Sketch of Service Here
31 Hayes Lane

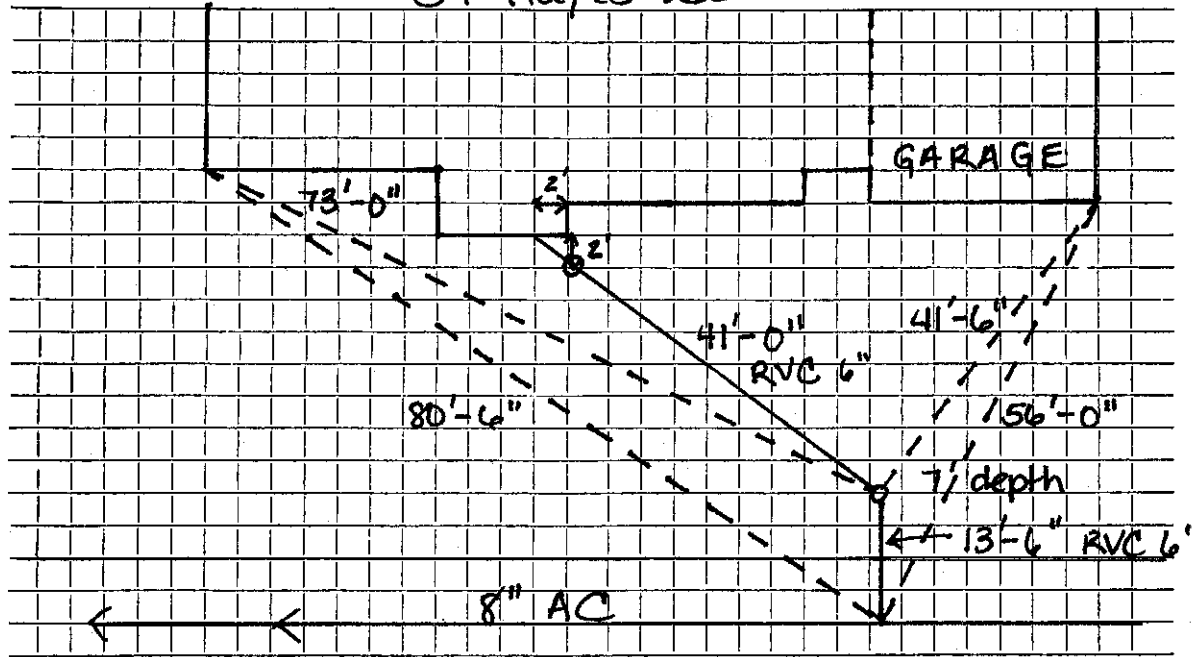

Connection made in Street. Work completed

Remarks: Installed by J.M. McLaughlin Inc.