


SEWER DIVISION

Sketch of Service Here

32

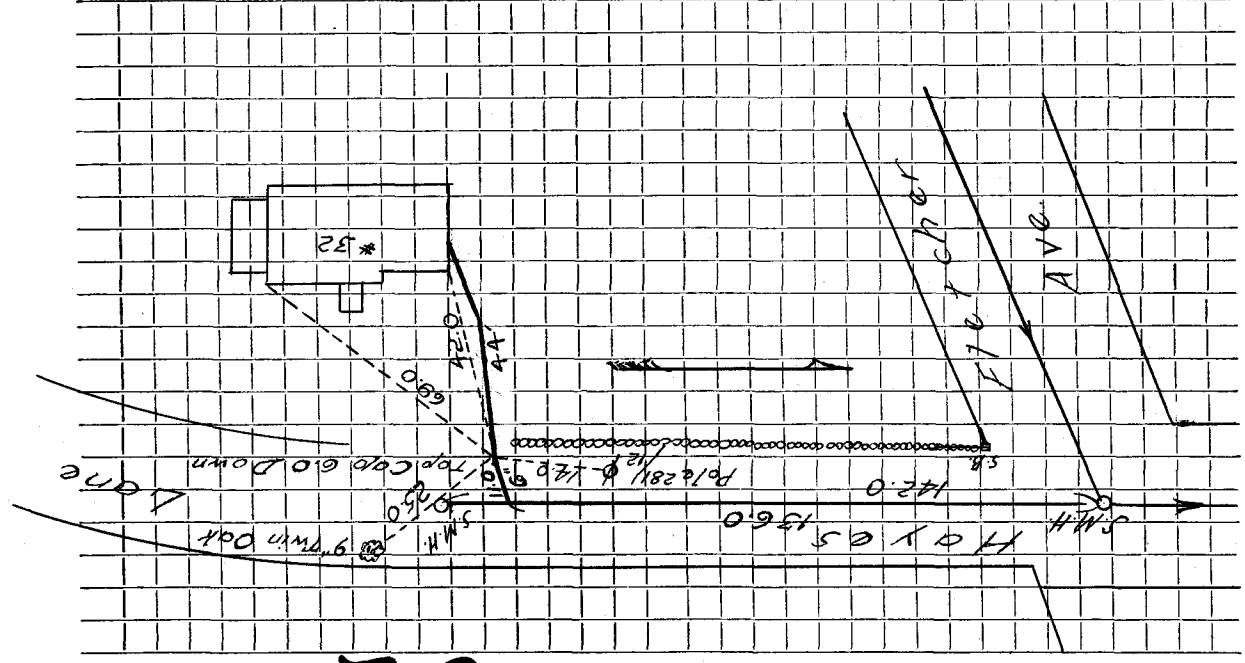

Connection made in Street. Work completed

Remarks: