


DATE 8/29/23

TOWN OF LEXINGTON — BOARD OF PUBLIC WORKS
SEWER DIVISION

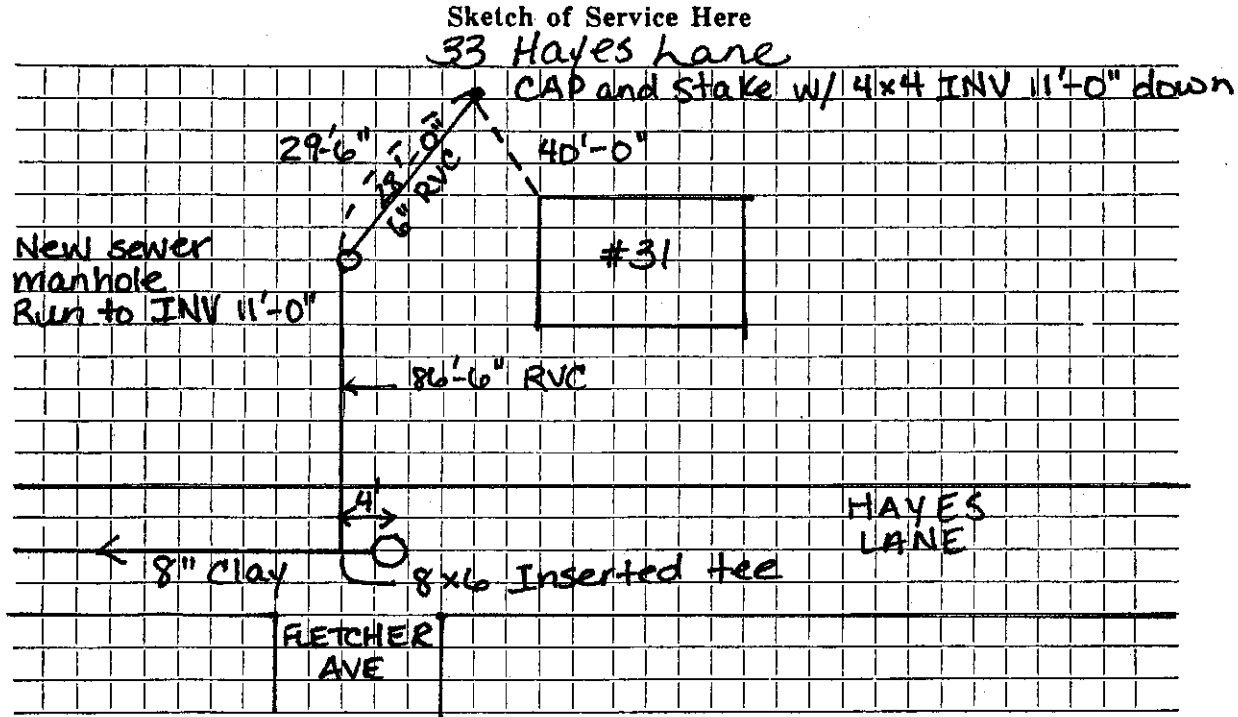

Connection made in Street. Work completed

Remarks:

.....