

Name John Ingraham

Service No. 38

Address 35 Hayes Lane

Location

Size of Main

Size

Kind of Pipe

Repair - Renewal - ~~Water Service~~ W.O. #3343

Location Conn Tab 25

Date	Material	Amount	Total	Date	Amount
5/23/75	Labor	47.42		5-16-75	Deposit
5/27/75	"	70.50		7-28-75	Retard
5/28/75	"	68.71			
5/29/75	"	46.55		5-23-75	
	10% O.H.	23.32	256.60		20' 6" Transite
40'	6" transite pipe @ 1.27 ft.		50.80		
2	5 x 6" Nipples @ 1.48 ft.		14.80		
1/4	Bag Cement @ 2.20		55		
4	24" x 6" Nip @ 5.53		22.12		
1	6" x 6" Wye		9.52		
6	5' x 6" Nip @ 1.48		44.40		
1	3' x 6" Nip		8.49		
2	1 1/4 elbow @ 3.94		7.88		
1	30 elbow		4.88		
1	6" Cap		3.75		
1	0 Ring		3.05		


TOWN OF LEXINGTON — BOARD OF PUBLIC WORKS

SEWER DIVISION

DATE _____

35

Sketch of Service Here

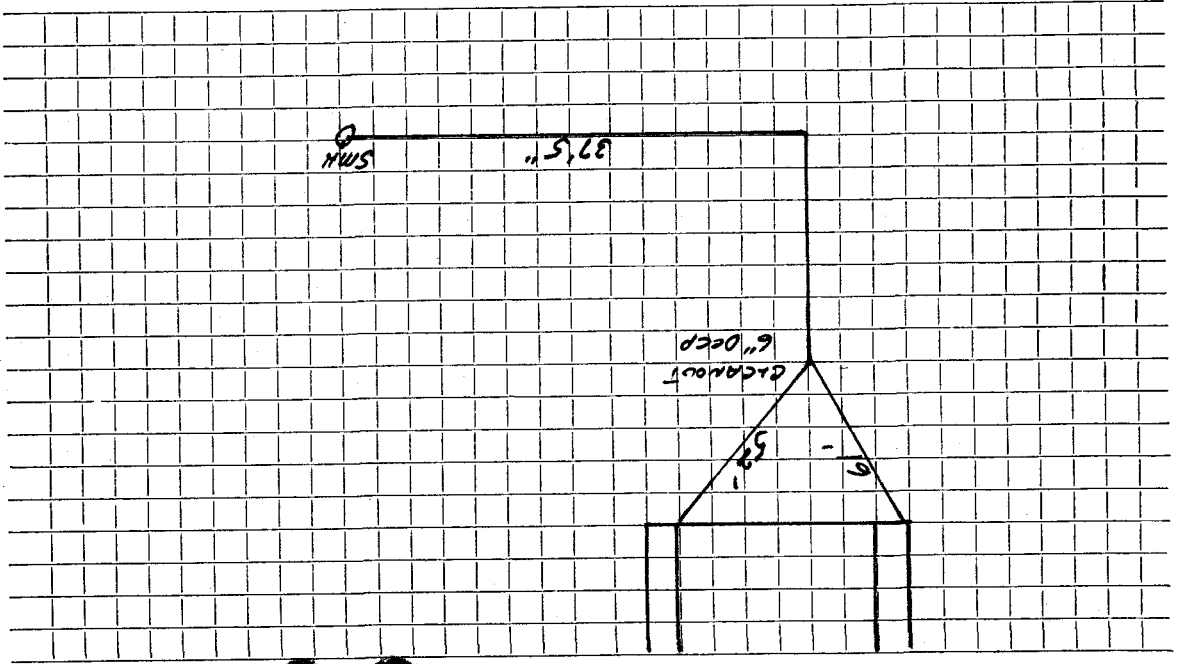

Work completed

Street

Connection made in

Remarks: Original Service 1938