


TOWN OF LEXINGTON — BOARD OF PUBLIC WORKS

SEWER DIVISION

DATE _____

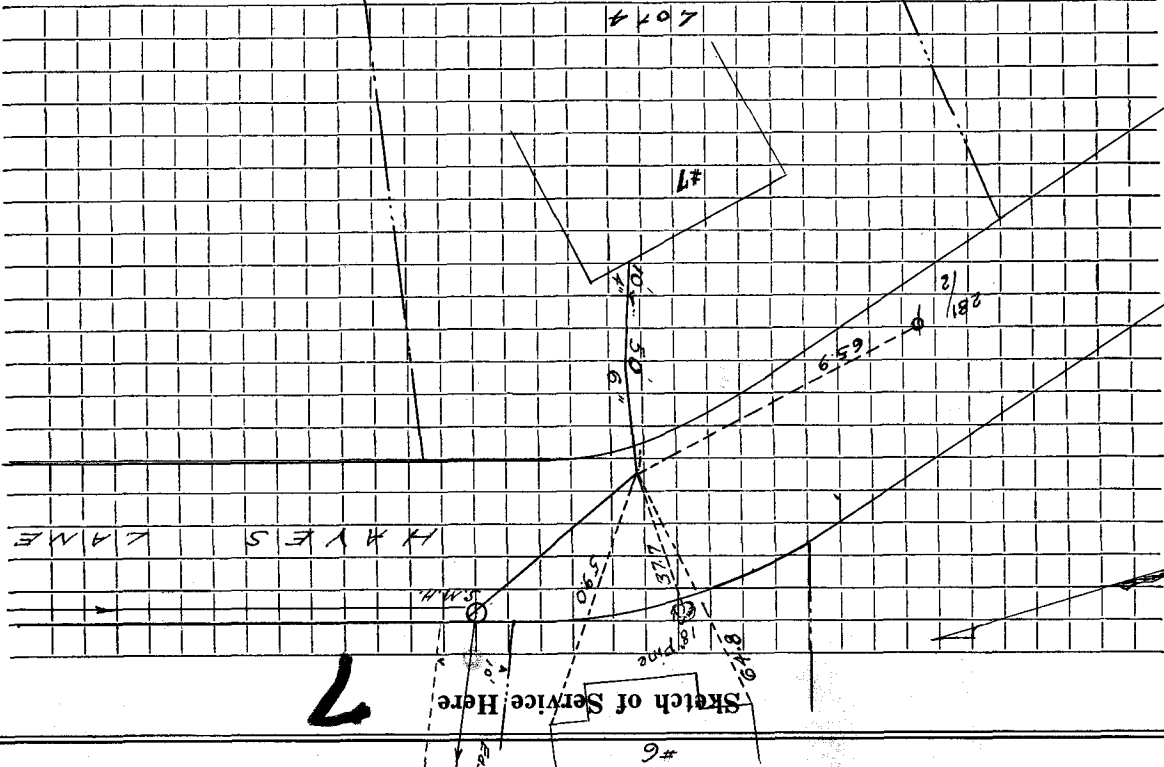

7

Connection made in Street. Work completed

Remarks: