




DATE Nov. 19, 1980

TOWN OF LEXINGTON — BOARD OF PUBLIC WORKS

SEWER DIVISION

Sketch of Service Here

12

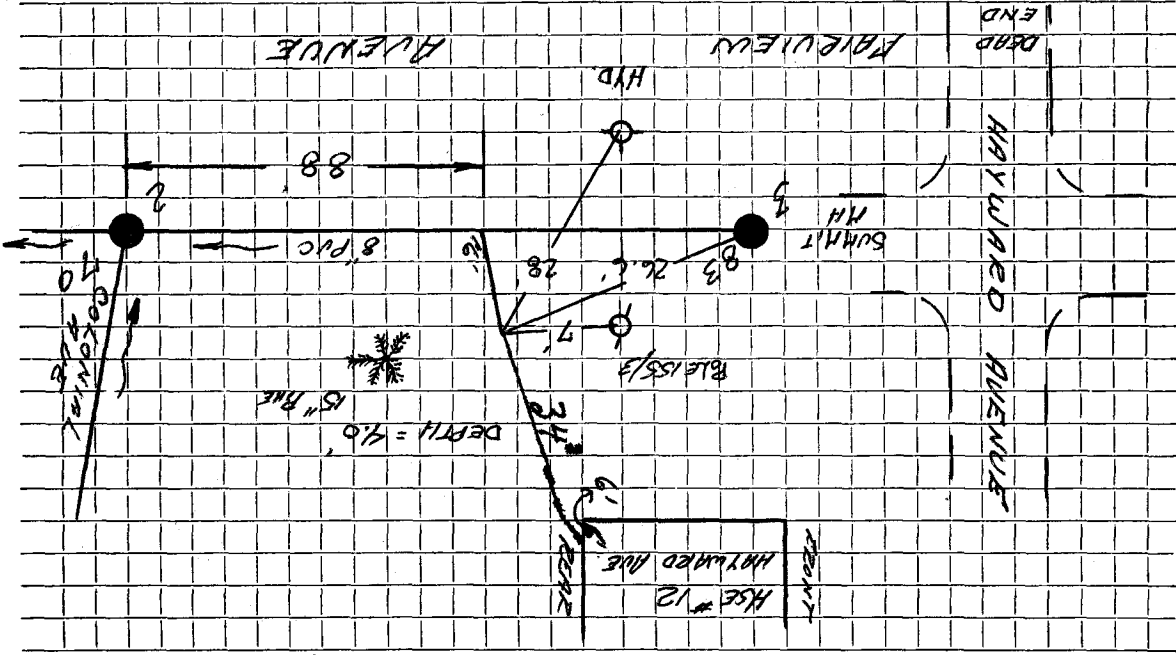

Connection made in ... FAIRVIEW Street. Work completed Nov. 19, 1980

Remarks: