




DATE Nov. 21, 1980

TOWN OF LEXINGTON — BOARD OF PUBLIC WORKS

SEWER DIVISION

25

Sketch of Service Here

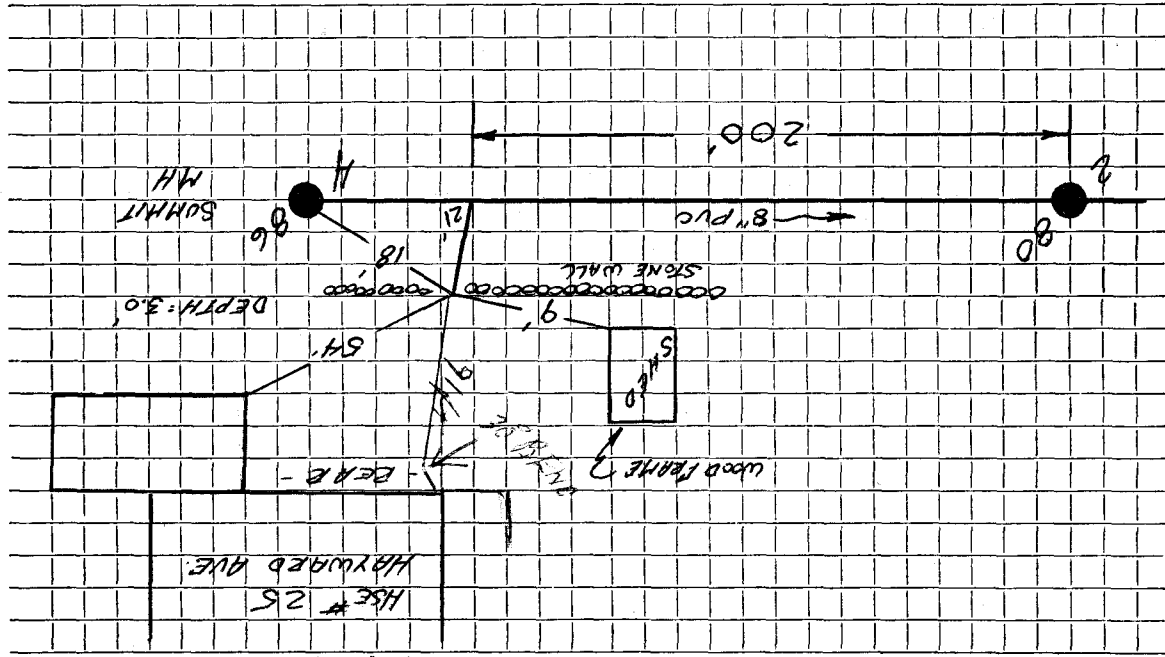

Connection made in SUNSET Street. Work completed Nov. 21, 1980.

Remarks: