




TOWN OF LEXINGTON — BOARD OF PUBLIC WORKS

SEWER DIVISION

DATE 12-8-80

Sketch of Service Here  
**29**

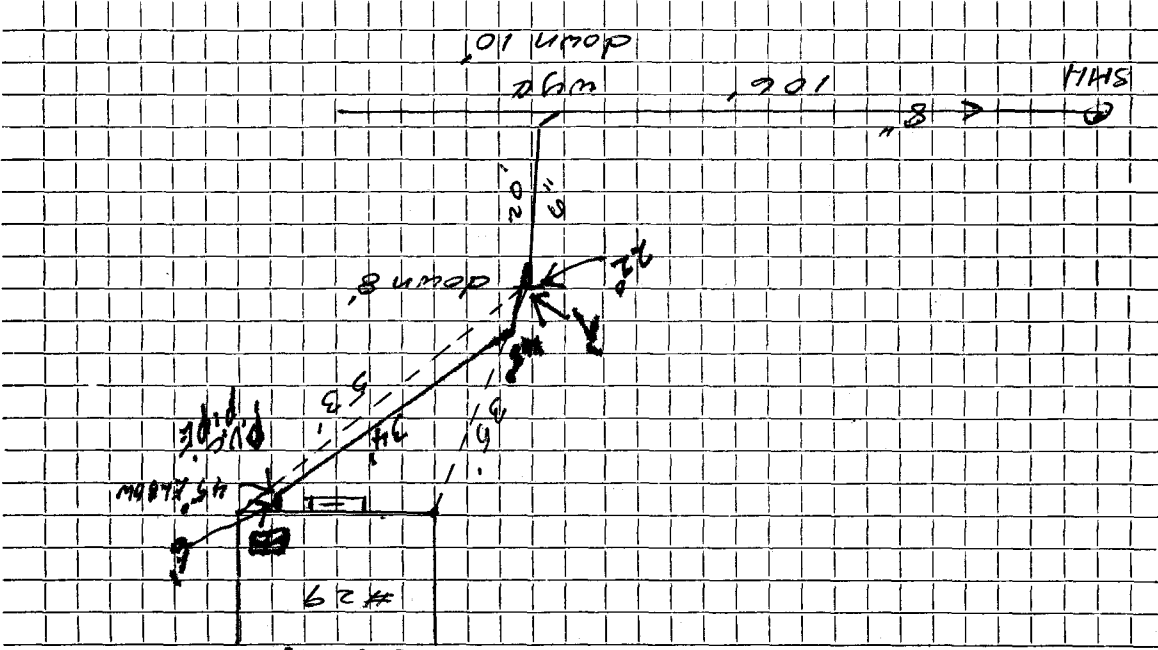

Connection made in HAYWARD AVE. Street. Work completed.

Remarks: