


DATE 12-8-80 Relaid to main 9-28-8

TOWN OF LEXINGTON — BOARD OF PUBLIC WORKS

SEWER DIVISION

Sketch of Service Here
31

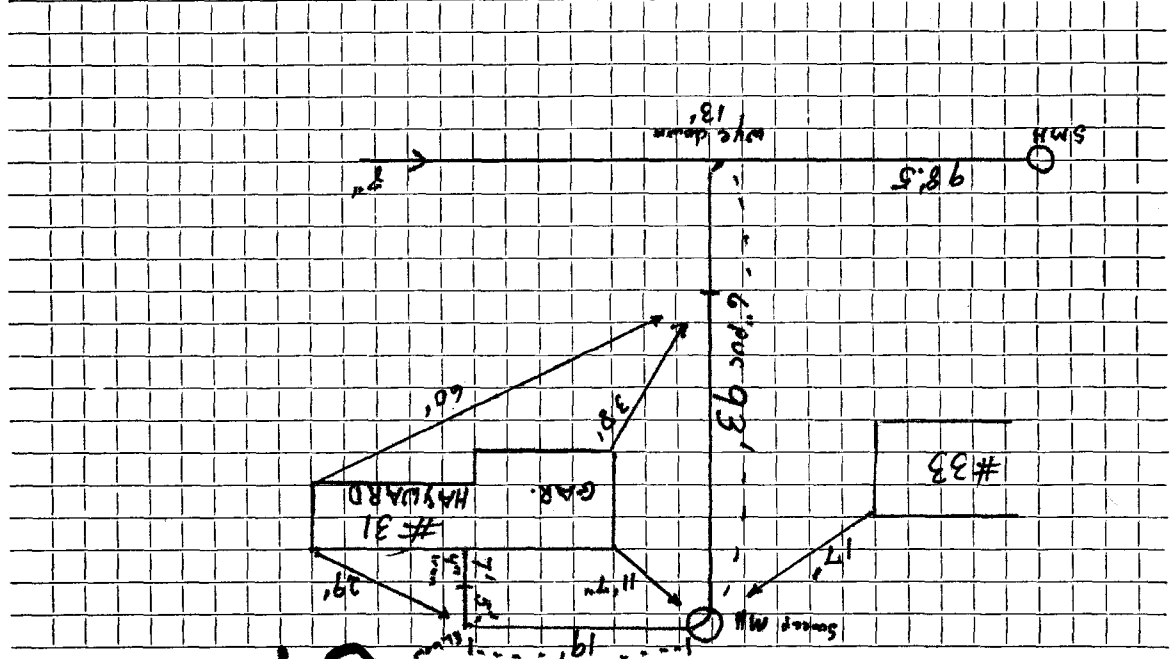

Connection made in HAYWARD AVE Street. Work completed

Remarks: Relaid from main to edge of rd by water meter to house