


TOWN OF LEXINGTON — BOARD OF PUBLIC WORKS

SEWER DIVISION

DATE _____

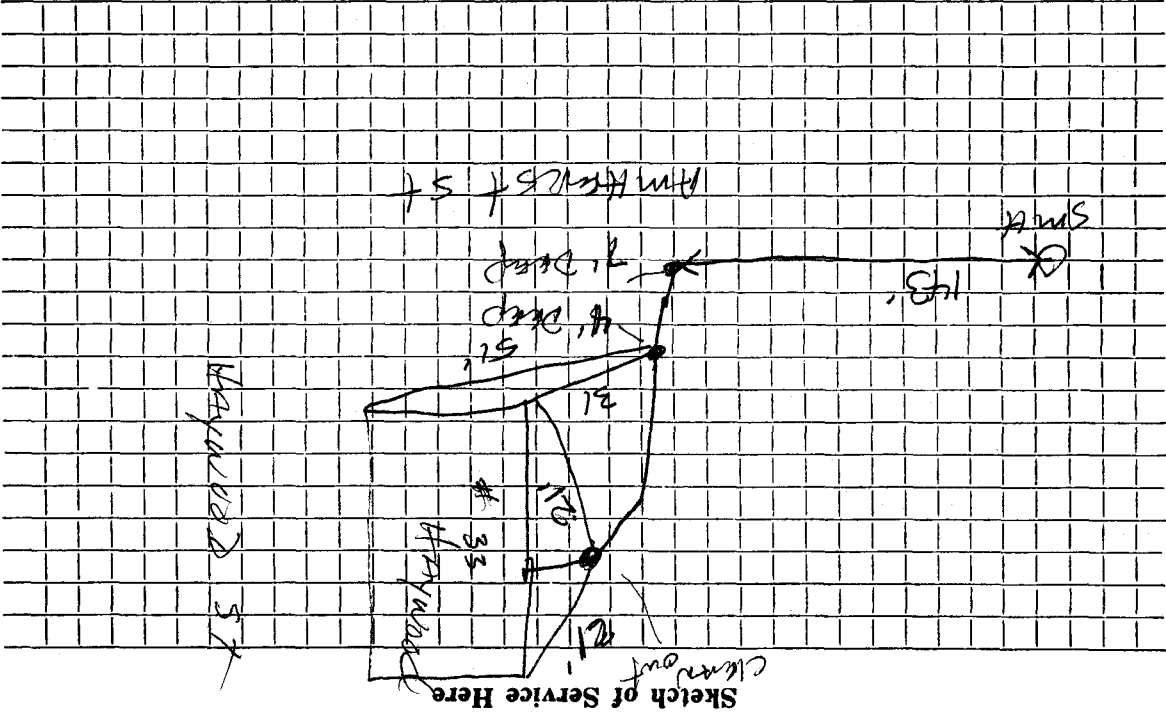

Work completed

Street
Service is connected on
Pinehurst St

Remarks:

Connection made in