



TOWN OF LEXINGTON — BOARD OF PUBLIC WORKS


SEWER DIVISION

DATE

8/17/95

Sketch of Service Here

35

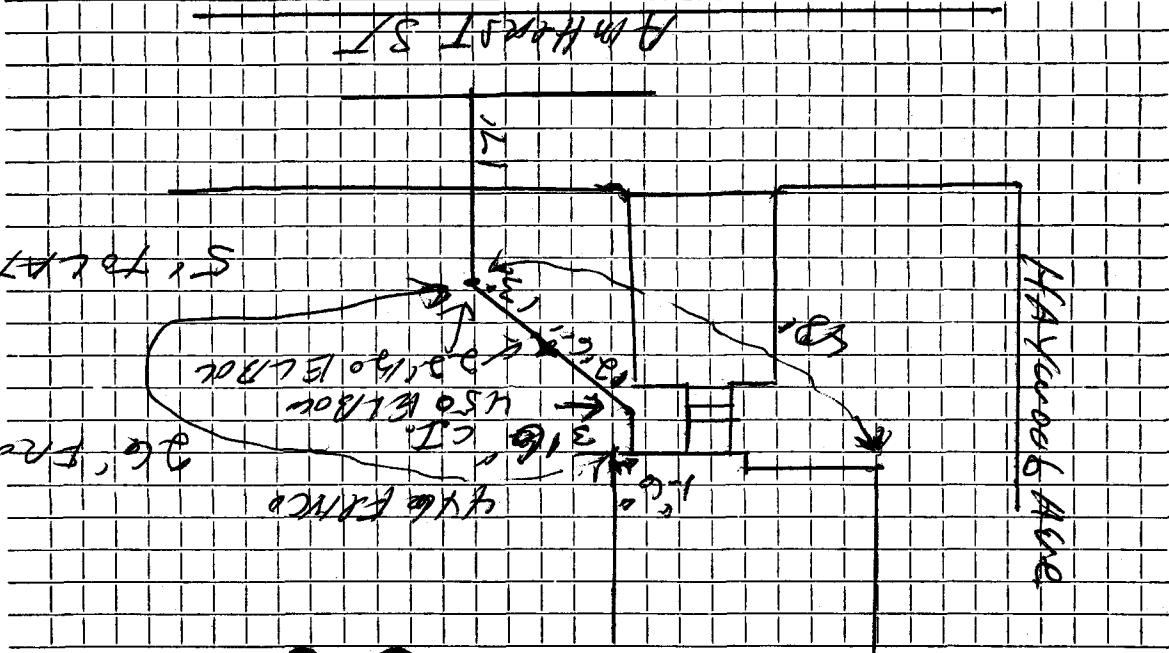

to lateral

to 5' from corner of house to lateral

Connection made in

AMHERST ST

Street.

Work completed

8/17/95

Remarks:

BRUCE S. MCKEE