


TOWN OF LEXINGTON — BOARD OF PUBLIC WORKS

SEWER DIVISION

DATE _____

Sketch of Service Here

4

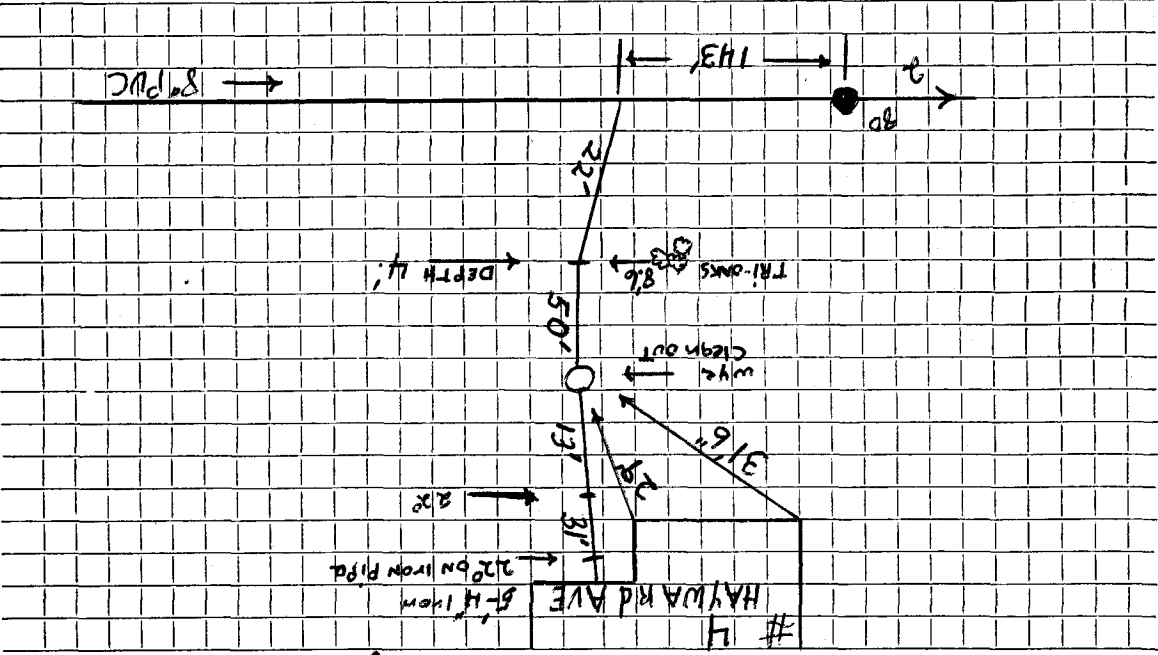

Connection made in Sunset Street. Work completed Nov 21, 1980 To Hse. 9-14-81

Remarks: