




TOWN OF LEXINGTON — BOARD OF PUBLIC WORKS

SEWER DIVISION

DATE \_\_\_\_\_

Sketch of Service Here

13

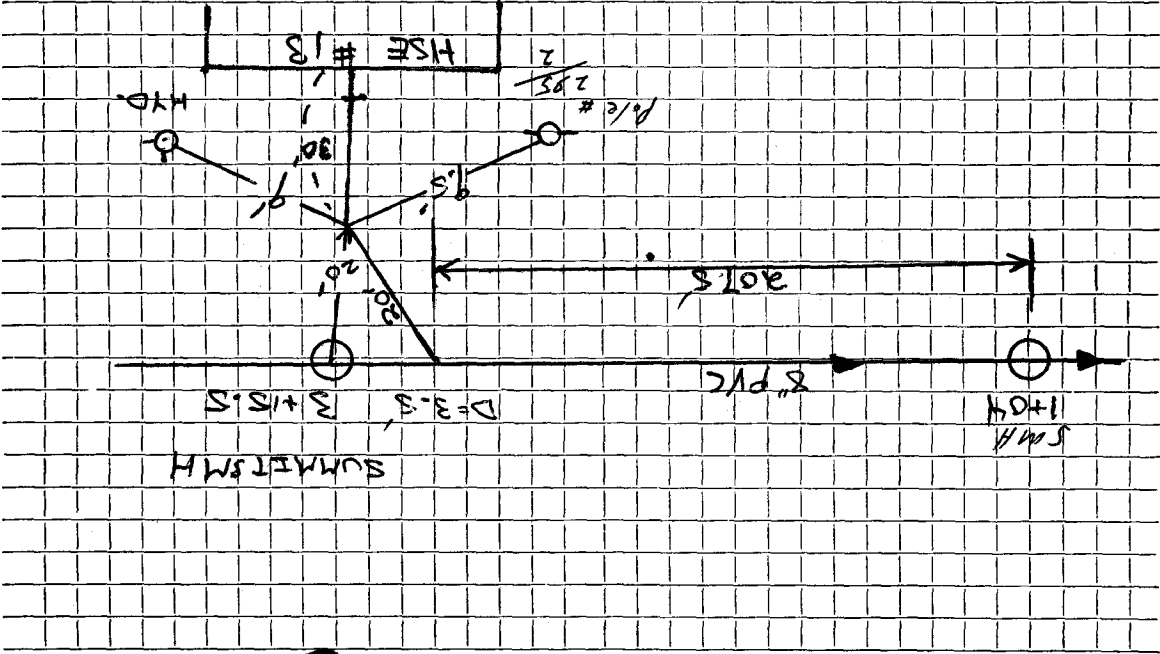

Work completed

Street

Hazel Road

Connection made in

Remarks:




TOWN OF LEXINGTON — BOARD OF PUBLIC WORKS

SEWER DIVISION

DATE \_\_\_\_\_

Sketch of Service Here

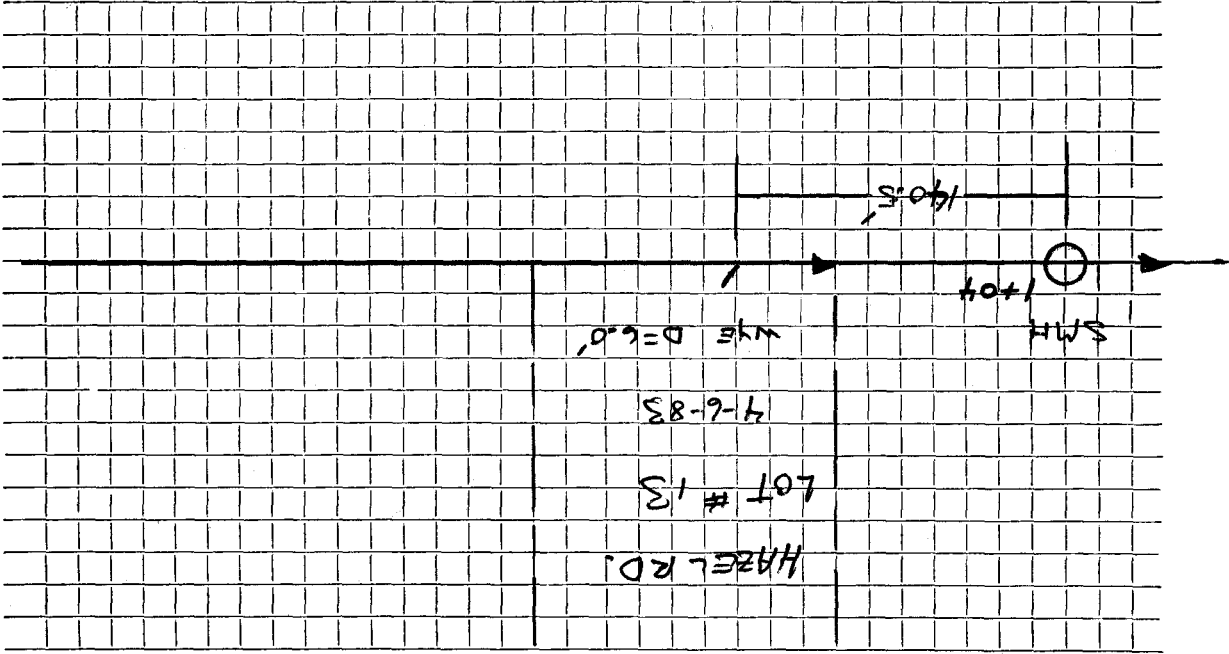

Work completed

~~Street.~~

Hazel Road

Connection made in

Remarks: