




TOWN OF LEXINGTON — BOARD OF PUBLIC WORKS

SEWER DIVISION

DATE \_\_\_\_\_

Sketch of Service Here  
 LOT 34 house No 4406  
 HAZEL RD

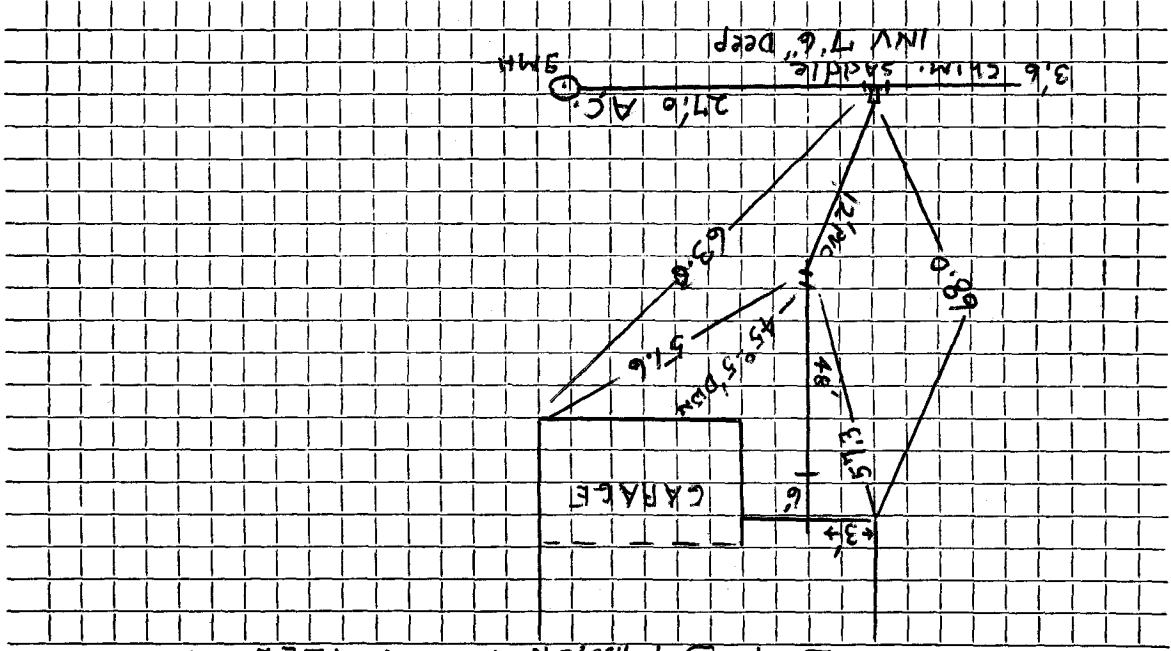

Work completed 1/25/04

Street.

Connection made in Ledge in RD

Remarks: