


TOWN OF LEXINGTON — BOARD OF PUBLIC WORKS

SEWER DIVISION

DATE _____

Sketch of Service Here

9

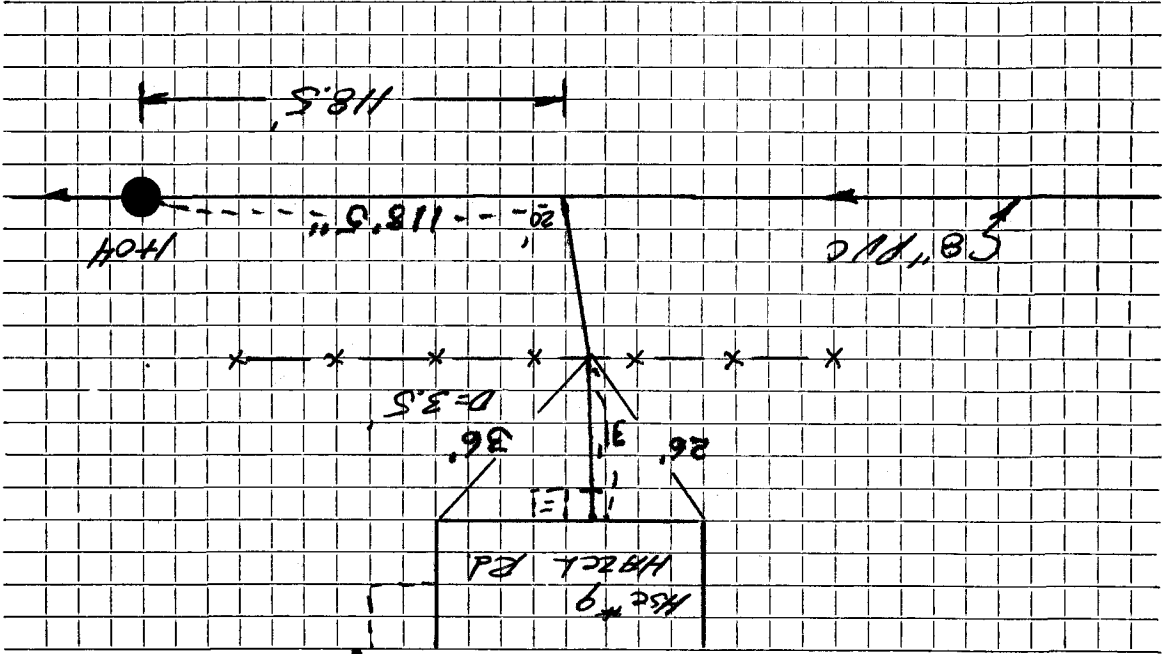

Connection made in HATCH ROAD Street. Work completed April 1983

Remarks: